

LINCOLN
 2017
 9-9-81

MISSISSIPPI
 BOARD OF WATER COMMISSIONERS
 416 North State Street
 Jackson, Mississippi 39201

WATER WELL DRILLERS LOG

9-9-81 date well completed
 Brunfield Well firm name
 Lincoln county well located

LANDOWNER: Lynn D Boyles
 Rt. 3
 Bogie Chittoms
 (mailing address)

WELL LOCATION:
 sec. 22.5 N R. 6 E
 2 1/4 miles NE of Auburn
 (distance) (direction) (nearest town)

WELL PURPOSE: home
 (home, irrigation, municipal, industrial)

- WELL COMPLETION DATA:
- diameter (inches) 4
 - total depth (feet) 70
 - static water level (feet) 42 below above top of ground.
 - casing PVC 80 (material) (depth)
4" (size) If telescope see back.
 - screen 10' 80 (length) (depth to top)
4 (size) PVC (material)
 - pump 1/2 Sub 10 (HP) (yield gpm)
Electric (type power)
 - electric log no (yes or no)
 - (organization running log)
 - how well bottom plugged Sand Shock

| description of formations encountered | from | to |
|---------------------------------------|------|----|
| Sandy Clay | 0 | 16 |
| SAND | 16 | 33 |
| CLAY | 33 | 43 |
| HARD SAND | 43 | 55 |
| SAND | 55 | 70 |
| SAND & SANDSTONE | 70 | 90 |


DRILLERS REMARKS:

DEPT. OF NATURAL RESOURCES
 BUREAU OF LAND & WATER RESOURCES

SEP 11 1981
 RECEIVED

If well telescopes please sketch and show depths.

GROUND LEVEL

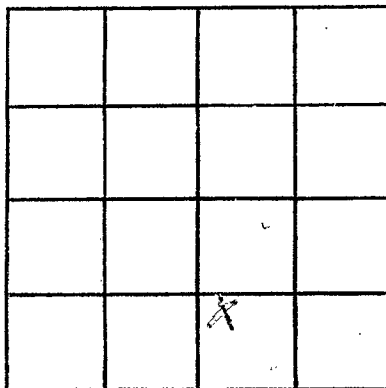

SECTION 102

Please indicate well location X.

ADDITIONAL INFORMATION

If more than one screen, show locations of each on sketch.