

Lincoln
 D 2018

MISSISSIPPI
 BOARD OF WATER COMMISSIONERS
 416 North State Street
 Jackson, Mississippi 39201

WATER WELL DRILLERS LOG

5-20
 date well completed

82 Brumfield Well Serv
 firm name

Lincoln
 county well located

LANDOWNER: T.R. Wise Jr.
 Rt # 5
 Bogue Chitto ms.
 (mailing address)

description of formations encountered	from	to
Surf Acc Clay	0	11
Clay	11	29
SAND + CLAY	29	55
SAND	55	80
SAND + ROCK	80	90

WELL LOCATION:
 sec. 13 T. 5 N R. 6 E
 1 miles S of Arlington
 (distance) (direction) (nearest town)

WELL PURPOSE: Home
 (home, irrigation, municipal, industrial)

- WELL COMPLETION DATA:
- (1) diameter (inches) 4
 - (2) total depth (feet) 90'
 - (3) static water level (feet) 59' below top of ground.
 - (4) casing Plastic 80'
 (material) (depth)
 4" (size) If telescope see back.
 - (5) screen 16' 80'
 (length) (depth to top)
 4" Plastic
 (size) (material)
 - (6) pump 1/2 8
 (HP) (yield gpm)
 Electric
 (type power)
 - (7) electric log No
 (yes or no)

(organization running log)
 Sand SAMM
 (8) how well bottom plugged

DRILLERS REMARKS:


DEPT. OF NATURAL RESOURCES
 BUREAU OF LAND & WATER RESOURCES

JUN - 8 1982

RECEIVED

If well telescopes please sketch and show depths.

GROUND LEVEL

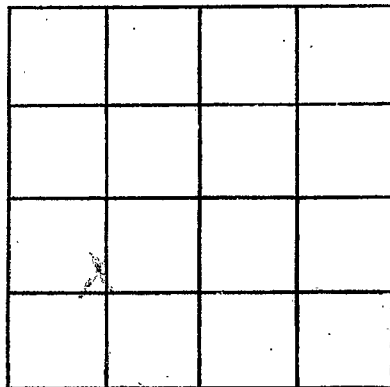

SECTION 13

Please indicate well location X.

ADDITIONAL INFORMATION

If more than one screen, show locations of each on sketch.