

Linder
0
2019

MISSISSIPPI
 BOARD OF WATER COMMISSIONERS
 416 North State Street
 Jackson, Mississippi 39201

WATER WELL DRILLERS LOG

6-2 date well completed 82 Brunfield firm name Well Linder county well located

LANDOWNER: Burt Sasser
Box 3
Bogue Chitto ms
 (mailing address)

description of formations encountered	from	to
<u>Sand + Acc Clay</u>	<u>0</u>	<u>18</u>
<u>SAND + Clay</u>	<u>18</u>	<u>36</u>
<u>GRAVEL</u>	<u>36</u>	<u>46</u>
<u>Wobly Sand</u>	<u>46</u>	<u>70</u>
<u>SAND + ROCK</u>	<u>70</u>	<u>90</u>

WELL LOCATION:
 sec. 12.5 T. S N. R. 6 E
Arlington Church
 (distance) (direction) (nearest town)

WELL PURPOSE: STOCK
 (home, irrigation, municipal, industrial)

- WELL COMPLETION DATA:
- (1) diameter (inches) 4
 - (2) total depth (feet) 90
 - (3) static water level (feet) 66 below top of ground.
 - (4) casing Plastic 80' (material) (depth)
4" (size) if telescope see back.
 - (5) screen 10' 80' (length) (depth to top)
4" (size) Plastic (material)
 - (6) pump 1/2 Sub 10 (HP) (yield gpm)
Electric (type power)
 - (7) electric log no (yes or no)

(organization running log)
Sand Shark
 (8) how well bottom plugged

DRILLERS REMARKS:


DEPT. OF NATURAL RESOURCES
 BUREAU OF LAND & WATER RESOURCES

JUN - 8 1982

RECEIVED

If well telescopes please sketch and show depths.

GROUND LEVEL

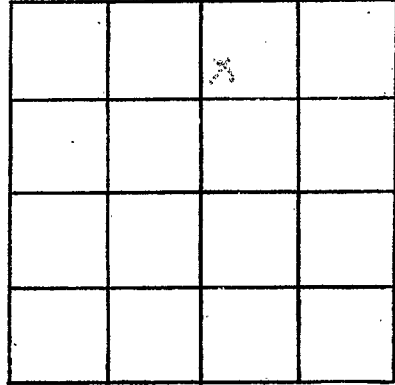

SECTION 12

Please indicate well location X.

ADDITIONAL INFORMATION

Lined area for additional information.

If more than one screen, show locations of each on sketch.