

Lincoln
0
2020

MISSISSIPPI
BOARD OF WATER COMMISSIONERS
416 North State Street
Jackson, Mississippi 39201

WATER WELL DRILLERS LOG

June 22 1982 Branfield Well Serv Lincoln
date well completed firm name county well located

LANDOWNER: Thompson
Pg. 3
Bogue Chitto, ms
(mailing address)

WELL LOCATION:
sec. 24 T. 5 N R. 6 E
10 1/2 miles N.W. of Summit
(distance) (direction) (nearest town)

WELL PURPOSE: none
(home, irrigation, municipal, industrial)

- WELL COMPLETION DATA:
- (1) diameter (inches) 4
 - (2) total depth (feet) 110
 - (3) static water level (feet) 62 below top of ground.
 - (4) casing Plastic, 100 (material) (depth)
4 (size) if telescope see back.
 - (5) screen 10' 80 (length) (depth to top)
4 Plastic (size) (material)
 - (6) pump 1/2 10 (HP) (yield gpm)
Electric (type power)
 - (7) electric log no (yes or no)

(8) how well bottom plugged Sand Shark
(organization running log)

description of formations encountered	from	to
Surface Clay	0	17
SANDY CLAY	17	38
Red CLAY	38	60
SAND	60	65
SAND & ROCK	65	71
HARD CLAY	71	96
SAND & ROCK	96	110


DEPT. OF NATURAL RESOURCES
BUREAU OF LAND & WATER RESOURCES

SEP - 3 1982

RECEIVED

If well telescopes please sketch and show depths.

GROUND LEVEL

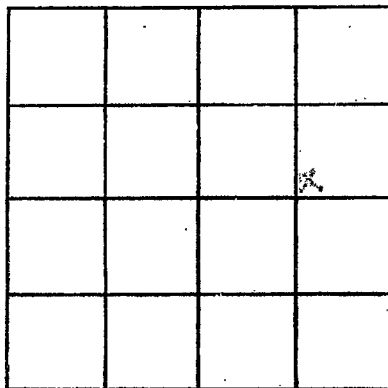

SECTION 24

Please indicate well location X.

ADDITIONAL INFORMATION

If more than one screen,
show locations of each on sketch.