

Lincoln
 Ozar

MISSISSIPPI
 BOARD OF WATER COMMISSIONERS
 416 North State Street
 Jackson, Mississippi 39201

WATER WELL DRILLERS LOG

Aug. 31 1982 Bronfield Well Serv Lincoln
 date/well completed firm name county well located

LANDOWNER: Archie Blain
Rt. Summit ms
 (mailing address)

description of formations encountered	from	to
<u>SURFACE CLAY</u>	<u>0</u>	<u>18</u>
<u>Red Sand</u>	<u>18</u>	<u>60</u>
<u>Red CLAY</u>	<u>60</u>	<u>63</u>
<u>SAND</u>	<u>63</u>	<u>74</u>
<u>SAND & ROCK</u>	<u>74</u>	<u>90</u>

WELL LOCATION:
 sec. 34 T 5 N R 6 E
1 miles E of Auburn
 (distance) (direction) (nearest town)

WELL PURPOSE: Home
 (home, irrigation, municipal, industrial)

- WELL COMPLETION DATA:
- (1) diameter (inches) 4"
 - (2) total depth (feet) 90'
 - (3) static water level (feet) 62 below above top of ground.
 - (4) casing Plastic, 80'
 (material) (depth)
4" If telescope see back.
 (size)
 - (5) screen 10', 80'
 (length) (depth to top)
4", Plastic
 (size) (material)
 - (6) pump 1/2 Sub, 7
 (HP) (yield gpm)
Electric
 (type power)
 - (7) electric log no
 (yes or no)
- (organization running log)
- (8) how well bottom plugged Sand's hard

DRILLERS REMARKS:


DEPT. OF NATURAL RESOURCES
 BUREAU OF LAND & WATER RESOURCES

SEP 29 1982

RECEIVED

If well telescopes please sketch and show depths.

GROUND LEVEL

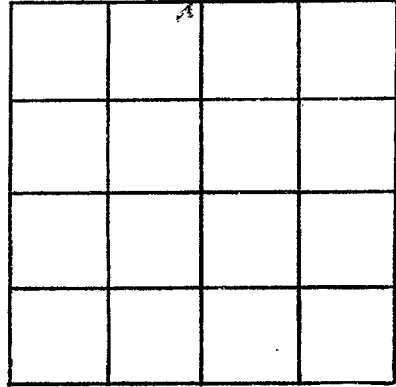

SECTION 34

Please indicate well location X.

ADDITIONAL INFORMATION

If more than one screen, show locations of each on sketch.