

MISSISSIPPI DEPARTMENT OF NATURAL RESOURCES

Bureau of Land and Water Resources

Southport Mall

P.O. Box 10631

Jackson, Mississippi 39209

WATER WELL DRILLERS LOG

Lincoln
0 2023

10-5
date well completed

1984 F. J. General Contracting
firm name

LINCOLN
county well located

LANDOWNER:	description of formations encountered	from	to
<u>LeROY EAST</u>			
<u>RR. Smithdale MS</u> (mailing address)	<u>Red clay</u>	<u>0</u>	<u>20</u>
	<u>Red sand</u>	<u>20</u>	<u>80</u>
	<u>Coarse sandstone</u>	<u>80</u>	<u>100</u>
WELL LOCATION:			
sec. <u>15</u> T. <u>5</u> N. R. <u>6</u> E. S. W.			
<u>4</u> miles <u>N</u> of <u>AUBURN</u> (distance) (direction) (nearest town)			
WELL PURPOSE: <u>Home</u> (home, irrigation, municipal, industrial)			
WELL COMPLETION DATA:			
(1) diameter (inches) <u>4</u>			
(2) total depth (feet) <u>100</u>			
(3) static water level (feet) <u>60</u> below above top of ground.			
(4) casing <u>MVC</u> , <u>92</u> , (material) (depth)			
<u>4</u> if telescope see back. (size)			
(5) screen <u>8</u> , <u>92</u> (length) (depth to top)			
<u>4</u> , <u>MVC</u> (size) (material)			
(6) pump <u>1/2</u> , <u>10</u> (HP) (yield gpm)			
<u>elm</u> (type power)			
(7) electric log <u>no</u> (yes or no)			
<u>Sal the</u> (organization running log)			
(8) how well bottom plugged <u>Sal the</u>			
DRILLERS REMARKS:			


DEPT. OF NATURAL RESOURCES
BUREAU OF LAND & WATER RESOURCES

DEC - 4 1984

RECEIVED

If well telescopes please
sketch and show depths.

GROUND LEVEL

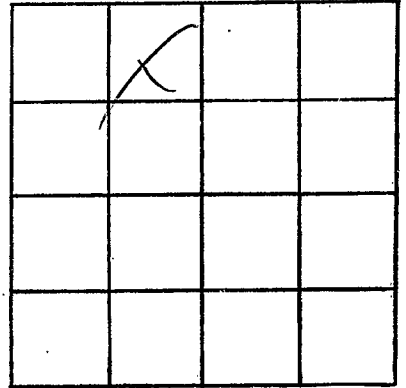

SECTION 15

Please indicate well location X.

ADDITIONAL INFORMATION

If more than one screen,
show locations of each on sketch.