

Lincal
 0 2024

MISSISSIPPI DEPARTMENT OF NATURAL RESOURCES
 Bureau of Land and Water Resources
 Southport Mall
 P.O. Box 10631
 Jackson, Mississippi 39209
WATER WELL DRILLERS LOG

1-11 1985 *Fitzgerald well serv* *Lincal*
 date well completed firm name county well located


LANDOWNER:
Alfreda Clay
P.R. Smithdale, Mo.
 (mailing address)

description of formations encountered	from	to
<i>Red clay</i>	<i>0</i>	<i>20</i>
<i>Red sand</i>	<i>20</i>	<i>90</i>
<i>Coarse sand & gravel</i>	<i>90</i>	<i>110</i>

WELL LOCATION:
 sec *36* T *5* N R *6* E
 S W
8 miles *W* of *Summit*
 (distance) (direction) (nearest town)

WELL PURPOSE: *Home*
 (home, irrigation, municipal, industrial)

- WELL COMPLETION DATA:
- (1) diameter (inches) 4
 - (2) total depth (feet) 110
 - (3) static water level (feet) 60 below above top of ground.
 - (4) casing PVC, 100,
 (material) (depth)
4 if telescope see back.
 (size)
 - (5) screen 10, 100
 (length) (depth to top)
4, PVC
 (size) (material)
 - (6) pump 1/2, 10
 (HP) (yield gpm)
Elec
 (type power)
 - (7) electric log no
 (yes or no)
 (organization running log)
 - (8) how well bottom plugged *Sand fill*

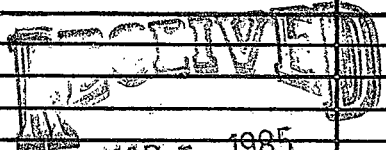

MAR 5 - 1985

DRILLERS REMARKS:

Department of Natural Resources
 Bureau of Land & Water Resources

