

**MISSISSIPPI DEPARTMENT OF NATURAL RESOURCES**  
**Bureau of Land and Water Resources**  
 Southport Mall  
 P.O. Box 10631  
 Jackson, Mississippi 39209  
**WATER WELL DRILLERS LOG**

LINCOLN
Q 2025

7-17 19 85 Grenn Water Well Lincoln  
 date well completed firm name county well located

LANDOWNER: Dalton Lofton, Rt. 2, Box 213 Smithdale, Ms.  
 (mailing address)

Description of formations encountered	from	to
Citronelle	1	118

**WELL LOCATION:**

sec 5 T 5 N R 6 E  
 S W  
 10 miles West of Bogue Chitto  
 (distance) (direction) (nearest town)

WELL PURPOSE: home  
 (home, irrigation, municipal, industrial)

**WELL COMPLETION DATA:**

(1) diameter (inches) 4  
 (2) total depth (feet) 118  
 (3) static water level (feet) 77 below above top of ground.

(4) casing PVC, 108'  
 (material) (depth)  
 4" if telescope see back.  
 (size)

(5) screen 10' / 108'  
 (length) (depth to top)  
 .010 PVC  
 (size) (material)

did (6) not install pump (HP) (yield gpm)  
 (type power)

(7) electric log no  
 (yes or no)

(organization running log)

(8) how well bottom plugged back wash valve


DRILLERS REMARKS:

**RECEIVED**  
 AUG 13 1985

Department of Natural Resources  
 Bureau of Land & Water Resources

If well telescopes please sketch and show depths.

GROUND LEVEL

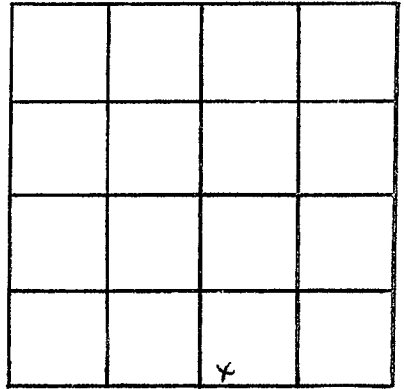

SECTION 5

Please indicate well location X.

ADDITIONAL INFORMATION

If more than one screen,  
show locations of each on sketch.