

MISSISSIPPI DEPARTMENT OF NATURAL RESOURCES

Bureau of Land and Water Resources

Southport Mall

P.O. Box 10631

Jackson, Mississippi 39209

WATER WELL DRILLERS LOG

2026
Lincoln
8-1-85

8-1 1985
date well completed

Fitzgerald Well Serv
firm name

Lincoln
county well located


LANDOWNER:	description of formations encountered	from	to
<u>Willie Watkins</u>			
<u>R.B. Summit, Mrs.</u> (mailing address)	<u>Red clay</u>	<u>0</u>	<u>20</u>
WELL LOCATION: sec. <u>35</u> T <u>5</u> N R. <u>6</u> E S W	<u>Red sand</u>	<u>20</u>	<u>100</u>
<u>2</u> miles <u>W</u> of <u>Summit</u> (distance) (direction) (nearest town)	<u>Coarse sand & gravel</u>	<u>100</u>	<u>118</u>
WELL PURPOSE: (home, irrigation, municipal, industrial)			
WELL COMPLETION DATA:			
(1) diameter (inches) <u>4</u>			
(2) total depth (feet) <u>118</u>			
(3) static water level (feet) <u>80</u> below above top of ground.			
(4) casing <u>PVC</u> , <u>108</u> , (material) (depth) <u>4</u> (size) if telescope see back.			
(5) screen <u>10</u> , <u>108</u> (length) (depth to top) <u>4</u> , <u>PVC</u> (size) (material)			
(6) pump <u>1/2</u> <u>10</u> (HP) (yield gpm) <u>Elec</u> (type power)			
(7) electric log <u>no</u> (yes or no) <u></u> (organization running log)			
(8) how well bottom plugged <u>Seal off</u>			
DRILLERS REMARKS:			

RECEIVED
SEP 13 1985

Department of Natural Resources
Bureau of Land & Water Resources

If well telescopes please sketch and show depths.

GROUND LEVEL

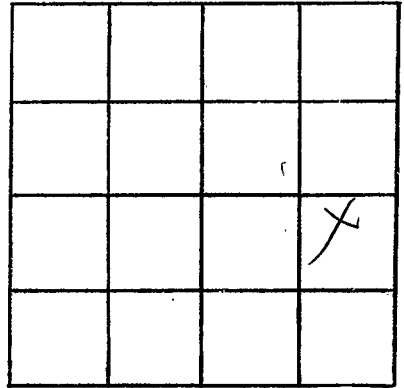

SECTION 35

Please indicate well location X.

ADDITIONAL INFORMATION

If more than one screen,
show locations of each on sketch.