

MISSISSIPPI DEPARTMENT OF NATURAL RESOURCES

Bureau of Land and Water Resources

Southport Mall

P.O. Box 10631

Jackson, Mississippi 39209

WATER WELL DRILLERS LOG

LINCOLN
Φ
2027

May 19 1986 Grenn Water Well Lincoln
 date well completed firm name county well located


LANDOWNER: Joe Jordan	description of formations encountered	from	to
Route 3			
Bogue Chitto, Ms. (mailing address)			
WELL LOCATION: sec. 32 T 5 N 6 R 6 E S W 11 miles SW of Bogue Chitto (distance) (direction) (nearest town)			
WELL PURPOSE: home (home, irrigation, municipal, industrial)			
WELL COMPLETION DATA:			
(1) diameter (inches) 4			
(2) total depth (feet) 113			
(3) static water level (feet) 48 below above top of ground.			
(4) casing PVC, 103' (material) (depth) 4" if telescope see back. (size)			
(5) screen 10', 103' (length) (depth to top) .010 PVC (size) (material)			
(6) pump did not install (HP) (yield gpm) (type power)			
(7) electric log no (yes or no) (organization running log)			
(8) how well bottom plugged back wash valve			
DRILLERS REMARKS:			

RECEIVED
 JUN 27 1986

Department of Natural Resources
 Bureau of Land & Water Resources

If well telescopes please sketch and show depths.

GROUND LEVEL

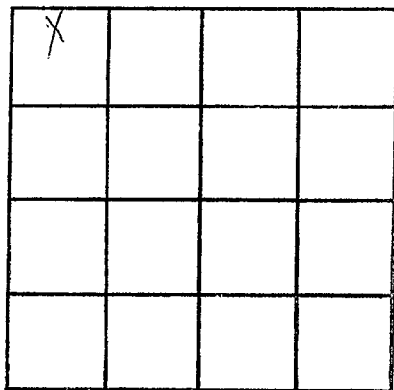

SECTION 32

Please indicate well location X.

ADDITIONAL INFORMATION

If more than one screen,
show locations of each on sketch.