

MISSISSIPPI DEPARTMENT OF NATURAL RESOURCES

Bureau of Land and Water Resources

Southport Mall

P.O. Box 10631

Jackson, Mississippi 39209

WATER WELL DRILLERS LOG

LINCOLN
 # 2028

11-21 1986 F. H. Hubbard Inc Tipton
 date well completed firm name county well located


LANDOWNER:	description of formations encountered	from	to
<u>Wallace Wheat</u>			
<u>R.R. Smithdale Mrs -</u> (mailing address)	<u>Red ch</u> <u>Red sand</u> <u>Coarse sand & gravel</u>	<u>0</u> <u>20</u> <u>80</u>	<u>20</u> <u>80</u> <u>95</u>
WELL LOCATION:			
sec. <u>27</u> T <u>5</u> N R <u>6</u> E S W			
<u>2</u> miles <u>E</u> of <u>AUBURN</u> (distance) (direction) (nearest town)			
WELL PURPOSE: <u>Home</u> (home, irrigation, municipal, industrial)			
WELL COMPLETION DATA:			
(1) diameter (inches) <u>4</u>			
(2) total depth (feet) <u>95</u>			
(3) static water level (feet) <u>67</u> below above top of ground.			
(4) casing <u>PVC</u> <u>87</u> (material) (depth) <u>4</u> if telescope see back. (size)			
(5) screen <u>10</u> <u>87</u> (length) (depth to top) <u>4</u> <u>PVC</u> (size) (material)			
(6) pump <u>1/2</u> <u>10</u> (HP) (yield gpm) <u>el</u> (type power)			
(7) electric log <u>no</u> (yes or no)			
(organization running log)			
(8) how well bottom plugged <u>al d</u>			
DRILLERS REMARKS:			

RECEIVED
 11/22/86

Department of Natural Resources
 Bureau of Land & Water Resources

If well telescopes please sketch and show depths.

GROUND LEVEL

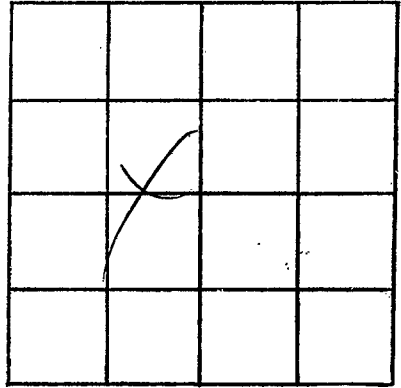

SECTION 27

Please indicate well location X.

ADDITIONAL INFORMATION

If more than one screen,
show locations of each on sketch.