

LINCOLN
0 2029

MISSISSIPPI DEPARTMENT OF NATURAL RESOURCES

Bureau of Land and Water Resources

Southport Mall

P.O. Box 10631

Jackson, Mississippi 39209

WATER WELL DRILLERS LOG

Feb 13 1987
date well completed

W. G. Gualand
firm name

Lincoln
county well located

LANDOWNER:	description of formations encountered	from	to
Small McKenzie			
R.R. Benechito (mailing address)	Red clay Red sand Coarse sand & gravel	0 15 60	15 60 82
WELL LOCATION:			
sec. <u>23</u> T <u>5</u> N R <u>6</u> E S W			
<u>4</u> miles <u>N</u> of <u>Arbuckle</u> (distance) (direction) (nearest town)			
WELL PURPOSE: <u>Home</u> (home, irrigation, municipal, industrial)			
WELL COMPLETION DATA:			
(1) diameter (inches) <u>4</u>			
(2) total depth (feet) <u>82</u>			
(3) static water level (feet) <u>22</u> below top of ground. above			
(4) casing <u>PVC</u> <u>72</u> (material) (depth) <u>4</u> if telescope see back. (size)			
(5) screen <u>10</u> <u>72</u> (length) (depth to top)			
<u>4</u> <u>PVC</u> (size) (material)			
(6) pump <u>1/2</u> <u>10</u> (HP) (yield gpm) <u>Electric</u> (type power)			
(7) electric log <u>No</u> (yes or no)			
(8) how well bottom plugged <u>Sand block</u>			

RECEIVED


MAR 20 1987

Department of Natural Resources
Bureau of Land & Water Resources

DRILLERS REMARKS:

If well telescopes please sketch and show depths.

GROUND LEVEL

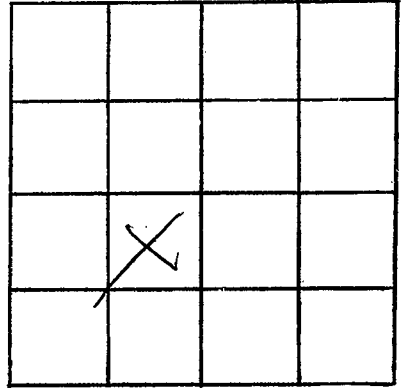

SECTION 23

Please indicate well location X.

ADDITIONAL INFORMATION

If more than one screen,
show locations of each on sketch.