

MISSISSIPPI DEPARTMENT OF NATURAL RESOURCES

Bureau of Land and Water Resources

COUNTY WELL LOCATED LINCOLN	
WELL NUMBER 189768	CODED
2046	
DATE WELL COMPLETED 1-30-93	

PERMIT NUMBER 510
NAME OF DRILLING FIRM Easley Water Well
Brookhaven, MS 39601

P.O. Box 10631
Jackson, Mississippi 39209
WATER WELL DRILLERS LOG

NAME & MAILING ADDRESS OF LANDOWNER Eddie Knox			
WELL LOCATION:	SEC	TOWNSHIP	RANGE
	<u>13</u>	<u>5</u> N	<u>6</u> E
		S	W
DISTANCE	DIRECTION	NEAREST TOWN	
_____ Miles	_____ of _____	_____	
OTHER LANDMARK			
WELL PURPOSE: Home, Irrigation, Municipal, Industrial, Fish Pond, etc.			

PUMP DATA		
PUMP TYPE (Circle One): Submersible, Turbine, Jet, Flowing Well, Other (Describe) <u>1/2 HP</u>		
POWER TYPE (Circle One): <u>Electric</u> , Tractor, Diesel, Gasoline, Butane, Other (Describe) _____		
Pump Capacity (GPM)	No. of Stages	Setting Depth
<u>10 GPM</u>		_____ FT.
PUMP TEST		
Well yielded _____ GPM with a drawdown of _____ ft. after _____ hours of pumping		

WELL DATA		
Well Depth	Casing Diameter (In.)	Casing Length (Ft.)
<u>120'</u>	<u>4"</u>	<u>100'</u>
Type of Casing	Hole Depth	Depth to Static Water Level
<u>PVC</u>	<u>120'</u>	
TYPE OF COMPLETION: (Circle One or More): Gravel Packed, Underreamed, Telescoped, Natural Development, Open Hole, Other (Describe) <u>Home</u>		
Top of Lap Pipe or Reduction in Casing		
FEET	IF TELESCOPED OR MORE THAN ONE SCREEN: USE BACK PAGE	

LOG DATA	
TYPE OF LOG RUN (Circle One): No Log Run, Electric, Gamma Ray, Density, Sonic, Neutron, Other (Describe) _____	
Name of Organization Running Log	


SCREEN DATA		
Diameter - Inches	Length - Feet	Slot Size - Inches
<u>4"</u>	<u>20'</u>	<u>12</u>
Screen Type	Depth to Bottom - Feet	
<u>PVC</u>	<u>120</u>	

GEOLOGIC DATA (Office Use Only)			
Surface Elev.	Geologic Unit	Unit Thickness	Depth to Top
Subs. SWL	Date	Analysis	Aquifer Test
Driller's Remarks			

DESCRIPTION OF FORMATIONS ENCOUNTERED	FROM	TO	FORMATIONS (Continued)	FROM	TO
<u>CLAY</u>	<u>0</u>	<u>10</u>	<div style="border: 2px solid black; padding: 5px; display: inline-block;"> RECEIVED JUL 05 1993 </div>		
<u>SAND + Gravel</u>	<u>10</u>	<u>100</u>			
<u>Coarse SAND</u>	<u>100</u>	<u>120</u>			
			Dept. of Environmental Quality Office of Land & Water Resources		
IF MORE SPACE IS NEEDED, USE BACK					

If well telescopes please sketch and show depths.

GROUND LEVEL

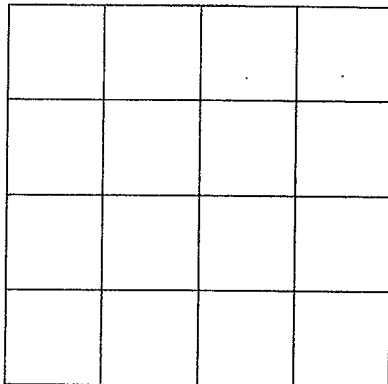

SECTION _____

Please indicate well location X.

ADDITIONAL INFORMATION

If more than one screen,
show location of each on sketch.