

MISSISSIPPI DEPARTMENT OF ENVIRONMENTAL QUALITY

Office of Land and Water Resources

P. O. Box 10631
Jackson, MS 39289-0631
WATER WELL DRILLERS LOG

COUNTY WELL LOCATED <u>LINCOLN</u>	
WELL NUMBER <u>2047</u>	CODED
DATE WELL COMPLETED <u>Oct 4-93</u>	

PERMIT NUMBER
NAME OF DRILLING FIRM <u>FILBERND Well Serv</u>

NAME & MAILING ADDRESS OF LANDOWNER <u>David De Blanc</u> <u>P.R. Boye Chitto ms.</u>		
WELL LOCATION: SEC <u>5</u> TOWNSHIP <u>5</u> RANGE <u>6</u>	N S E W	
DISTANCE <u>3</u> Miles	DIRECTION <u>W</u>	NEAREST TOWN <u>ARLINGTON</u>
OTHER LANDMARK		
WELL PURPOSE: Home, Irrigation, Municipal, Industrial, Fish Pond, etc.		

PUMP DATA		
PUMP TYPE (Circle One): <u>Submersible</u> , Turbine, Jet, Flowing Well, Other (Describe)		
POWER TYPE (Circle One): <u>Electric</u> , Tractor, Diesel, Gasoline, Butane, Other (Describe) <u>H/P</u>		
Pump Capacity (GPM) <u>10</u>	No. of Stages <u>12</u>	Setting Depth <u>120</u> FT.
PUMP TEST		
Well yielded <u>25</u> GPM with a drawdown of <u>2</u> ft. after <u>2</u> hours of pumping		

WELL DATA		
Well Depth <u>138</u>	Casing Diameter (In.) <u>4</u>	Casing Length (Ft.) <u>128</u>
Type of Casing <u>PWC</u>	Hole Depth <u>138</u>	Depth to Static Water Level <u>83</u>

LOG DATA	
TYPE OF LOG RUN (Circle One): Electric, Gamma Ray, Density, Sonic, Neutron, Other (Describe) <u>No Log Run</u>	
Name of Organization Running Log	

TYPE OF COMPLETION: (Circle One or More): <u>Gravel Packed</u> , Underreamed, Telescoped, Natural Development, Open Hole, Other	
WELL GROUTED TO A DEPTH OF <u>10</u> FEET Type Grout (circle one): Cement, Bentonite, or Mix	

GEOLOGIC DATA (Office Use Only)			
Surface Elev.	Geologic Unit	Unit Thickness	Depth to Top
Subs. SWL	Date	Analysis	Aquifer Test

SCREEN DATA		
Diameter - Inches <u>4</u>	Length - Feet <u>10</u>	Slot Size - Inches <u>1014</u>
Screen Type <u>PWC</u>	Depth to Bottom - Feet <u>138</u>	

Driller's Remarks


DESCRIPTION OF FORMATIONS ENCOUNTERED	FROM	TO
<u>Red Clay</u>	<u>0</u>	<u>20</u>
<u>Red Sand</u>	<u>20</u>	<u>121</u>
<u>COURSE SAND & GRAVEL</u>	<u>121</u>	<u>138</u>

FORMATIONS (Continued)	FROM	TO
RECEIVED		
OCT 22 1993		
Dept. of Environmental Quality Office of Land & Water Resources		

IF MORE SPACE IS NEEDED, USE BACK

If well telescopes please sketch and show depths.

GROUND LEVEL

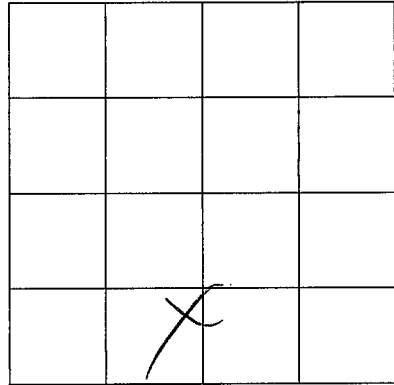

SECTION 5

Please indicate well location X.

ADDITIONAL INFORMATION

If more than one screen,
show location of each on sketch.