

LINCOLN

MISSISSIPPI
BOARD OF WATER COMMISSIONERS
416 North State Street
Jackson, Mississippi 39201

3/20/78

2048

WATER WELL DRILLERS LOG

March 20th 19 78 Grenn Water Well Contractor Lincoln

date well completed

firm name

county well located

LANDOWNER: Phillip Jordan

9511 Gov. Beauvais Dr.

Baton Rouge, La 70811

(mailing address)

description of formations encountered

from

to

Citronelle

1

90

WELL LOCATION:

sec. 20~~35~~ N R. 6~~5~~ E

12 miles SW Bogueta

(distance) (direction) (nearest town)

WELL PURPOSE: home
(home, irrigation, municipal, industrial)

WELL COMPLETION DATA:

(1) diameter (inches) 6

(2) total depth (feet) 90

(3) static water level (feet) 55 below above top of ground.

(4) casing PVC 84
(material) (depth)

4" If telescope see back.
(size)

(5) screen 6' 84
(length) (depth to top)

.010 PVC
(size) (material)

(6) pump 1/2 HP sub 10
(HP) (yield gpm)

electricity
(type power)

(7) electric log no
(yes or no)

(organization running log)

(8) how well bottom plugged
backwash valve


DRILLERS REMARKS:

RECEIVED
APR 17 1978

MISS. BD. OF WATER COMM.

If well telescopes please sketch and show depths.

GROUND LEVEL

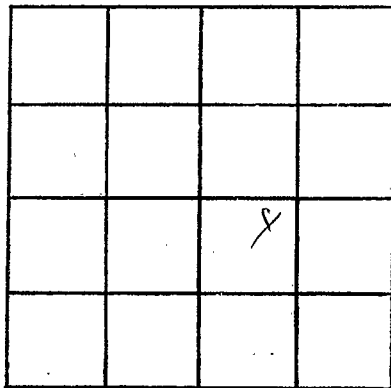

SECTION 20

Please indicate well location X.

ADDITIONAL INFORMATION

If more than one screen, show locations of each on sketch.