

LINCOLN
 2049
 May 11, 1979

MISSISSIPPI
 BOARD OF WATER COMMISSIONERS
 416 North State Street
 Jackson, Mississippi 39201

WATER WELL DRILLERS LOG

May 11 1979 Grenn Water Well Cont. Lincoln
 date well completed firm name county well located

LANDOWNER: Jimmy Whittington Route 2	Description of formations encountered citronelle	from 1	to 128
Bogue Chitto, Miss. (mailing address)			
WELL LOCATION: sec 8 T 5 N R 6 E 9 SW Bogue Chitto (distance) miles (direction) of (nearest town)			
WELL PURPOSE: home (home, irrigation, municipal, industrial)			
WELL COMPLETION DATA: (1) diameter (inches) 4 (2) total depth (feet) 128 (3) static water level (feet) 70 below above top of ground (4) casing PVC 116 (material) (depth) 4" (size) if telescope see back. (5) screen 12' 116' (length) (depth to top) .010 PVC (size) (material) (6) pump did not install (HP) (yield gpm) (type power) (7) electric log no (yes or no) (organization running log) (8) how well bottom plugged back wash valve			
DRILLERS REMARKS:			


Miss. Board of Water Comm.

JUL 9 1979

RECEIVED

If well telescopes please sketch and show depths.

GROUND LEVEL

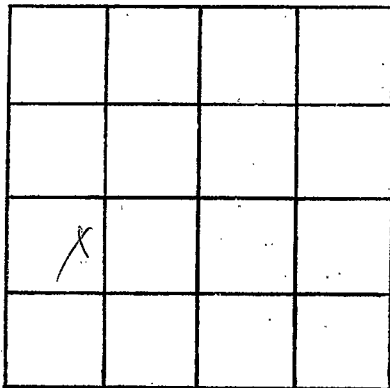

SECTION 8

Please indicate well location X.

ADDITIONAL INFORMATION

If more than one screen,
show locations of each on sketch.