

Lincoln
 \$ 2050
 6-14-79

MISSISSIPPI
 BOARD OF WATER COMMISSIONERS
 416 North State Street
 Jackson, Mississippi 39201

WATER WELL DRILLERS LOG

June 14, 1979 Reynolds Well Services Lincoln
 date well completed firm name county well located

LANDOWNER: (Contractor)
Burnett Thompson
At-3 - Boguechitto
 (mailing address)

description of formations encountered	from	to
clay	0	16
Red Chalk	16	55
loamy	55	100
small gravel sand	110	122

WELL LOCATION:
 sec. 25 T-5 N R-6 E
3 1/2 miles NE of Auburn
 (distance) (direction) (nearest town)

WELL PURPOSE: home
 (home, irrigation, municipal, industrial)

- WELL COMPLETION DATA:
- (1) diameter (inches) 4"
 - (2) total depth (feet) 122
 - (3) static water level (feet) 85 below top of ground.
 - (4) casing plastic bottom
 (material) (depth)
 - (size) if telescope see back.
 - (5) screen 5' 117
 (length) (depth to top)
 - 4" plastic
 (size) (material)
 - (6) pump 1/2 10
 (HP) (yield gpm)
 - slat
 (type power)
 - (7) electric log no
 (yes or no)

(organization running log)


(8) how well bottom plugged
plastic plug

DRILLERS REMARKS:

DEPT. OF NATURAL RESOURCES
 BUREAU OF LAND & WATER RESOURCES
 JAN 22 1980
 RECEIVED

If well telescopes please sketch and show depths.

GROUND LEVEL

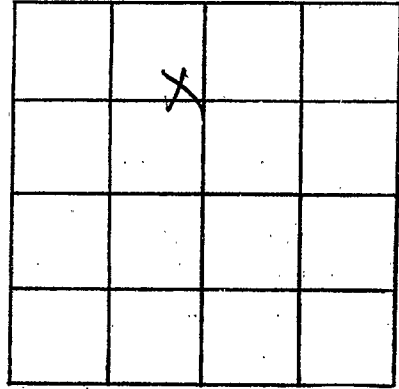

SECTION 25

Please indicate well location X.

ADDITIONAL INFORMATION

If more than one screen, show locations of each on sketch.