

Lincoln
Q 2051

3-13-80
3-13 1980

MISSISSIPPI
 BOARD OF WATER COMMISSIONERS
 416 North State Street
 Jackson, Mississippi 39201

WATER WELL DRILLERS LOG

date well completed 3-13 1980 firm name Fitzgibbon Inc county well located Lincoln

LANDOWNER:	description of formations encountered	from	to
<u>Sam Bolin</u>			
<u>R.B. Bozwick</u> (mailing address)	<u>Red Clay</u> <u>Red sand</u> <u>Green sand & gravel</u>	<u>0</u> <u>20</u> <u>140</u>	<u>20</u> <u>140</u> <u>159</u>
WELL LOCATION:			
sec. <u>26</u> T <u>5</u> N R <u>6</u> E S W			
<u>7</u> miles <u>E</u> of <u>Auburn</u> (distance) (direction) (nearest town)			
WELL PURPOSE: (home, irrigation, municipal, industrial)			
WELL COMPLETION DATA:			
(1) diameter (inches) <u>4</u>			
(2) total depth (feet) <u>159</u>			
(3) static water level (feet) <u>25</u> below top of ground. above			
(4) casing <u>4</u> inches <u>151</u> feet (material) (depth) <u>4</u> (size) if telescope see back.			
(5) screen <u>8</u> inches <u>151</u> feet (length) (depth to top) <u>4</u> (size) <u>40</u> (material)			
(6) pump <u>1/2</u> HP <u>10</u> yield gpm <u>Elco</u> (type power)			
(7) electric log <u>no</u> (yes or no) (organization running log)			
(8) how well bottom plugged <u>Sand fill</u>			
DRILLERS REMARKS:			


DEPT. OF NATURAL RESOURCES
 BUREAU OF LAND & WATER RESOURCES

MAR 25 1980

RECEIVED

If well telescopes please
sketch and show depths.

GROUND LEVEL

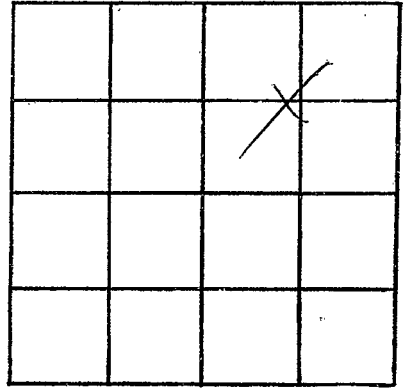

SECTION 26

Please indicate well location X.

ADDITIONAL INFORMATION

If more than one screen,
show locations of each on sketch.