

**MISSISSIPPI DEPARTMENT OF ENVIRONMENTAL QUALITY**

Office of Land and Water Resources

P. O. Box 10631  
Jackson, MS 39289-0631  
**WATER WELL DRILLERS LOG**

COUNTY WELL LOCATED <i>Lincoln</i>	
WELL NUMBER <i>2069</i>	CODED
DATE WELL COMPLETED <i>1-9-98</i>	

PERMIT NUMBER
NAME OF DRILLING FIRM <i>Fitzgerald Well</i>

NAME & MAILING ADDRESS OF LANDOWNER <i>Charlie Wallace</i>			
<i>Flynt RL Summit MS</i>			
WELL LOCATION:	SEC	TOWNSHIP	RANGE
	<i>17</i>	<i>5</i>	<i>N 6 E</i>
DISTANCE	DIRECTION	NEAREST TOWN	
<i>10</i> Miles	<i>west</i>	<i>Summit</i>	
OTHER LANDMARK			
WELL PURPOSE: <input checked="" type="checkbox"/> Home Irrigation, <input type="checkbox"/> Municipal, <input type="checkbox"/> Industrial, <input type="checkbox"/> Fish Pond, etc.			

<b>PUMP DATA</b>		
PUMP TYPE (Circle One): <input checked="" type="checkbox"/> Submersible, <input type="checkbox"/> Turbine, <input type="checkbox"/> Jet, <input type="checkbox"/> Flowing Well, Other (Describe) _____		
POWER TYPE (Circle One): <input checked="" type="checkbox"/> Electric, <input type="checkbox"/> Tractor, <input type="checkbox"/> Diesel, <input type="checkbox"/> Gasoline, <input type="checkbox"/> Butane, Other (Describe) _____ H/P <i>1/2</i>		
Pump Capacity (GPM) <i>10</i>	No. of Stages	Setting Depth <i>90</i> FT.
PUMP TEST		
Well yielded _____ GPM with a drawdown of _____ ft. after _____ hours of pumping		

<b>WELL DATA</b>		
Well Depth <i>105</i>	Casing Diameter (In.) <i>4"</i>	Casing Length (Ft.) <i>95"</i>
Type of Casing <i>PVC</i>	Hole Depth <i>105'</i>	Depth to Static Water Level <i>79'</i>
TYPE OF COMPLETION: (Circle One or More): <input checked="" type="checkbox"/> Gravel Packed, <input type="checkbox"/> Underreamed, <input type="checkbox"/> Telescoped, <input type="checkbox"/> Natural Development, <input type="checkbox"/> Open Hole, <input type="checkbox"/> Other		
WELL GROUTED TO A DEPTH OF <u><i>10</i></u> FEET Type Grout (circle one): Cement, Bentonite, <input checked="" type="checkbox"/> Mix		

<b>LOG DATA</b>	
TYPE OF LOG RUN (Circle One): <input type="checkbox"/> No Log Run, <input type="checkbox"/> Electric, <input type="checkbox"/> Gamma Ray, <input type="checkbox"/> Density, <input type="checkbox"/> Sonic, <input type="checkbox"/> Neutron, Other (Describe) _____	
Name of Organization Running Log	

<b>SCREEN DATA</b>		
Diameter - Inches <i>4"</i>	Length - Feet <i>10</i>	Slot Size - Inches <i>.012</i>
Screen Type <i>PVC</i>	Depth to Bottom - Feet <i>105'</i>	

<b>GEOLOGIC DATA (Office Use Only)</b>			
Surface Elev.	Geologic Unit	Unit Thickness	Depth to Top
Subs. SWL	Date	Analysis	Aquifer Test
Driller's Remarks			
Top of Lap Pipe or Reduction in Casing			
FEET <input type="checkbox"/> IF TELESCOPED OR MORE THAN ONE SCREEN: USE BACK PAGE			


DESCRIPTION OF FORMATIONS ENCOUNTERED	FROM	TO	FORMATIONS (Continued)	FROM	TO
<i>Top Soil,</i>	<i>0</i>	<i>5</i>	<b>RECEIVED</b>  <b>MAR 12 1998</b>  <b>Dept. of Environmental Quality Office of Land &amp; Water Resources</b>		
<i>clay</i>	<i>5</i>	<i>25</i>			
<i>Sand &amp; gravel</i>	<i>25</i>	<i>40</i>			
<i>clay</i>	<i>40</i>	<i>60</i>			
<i>Sand &amp; gravel</i>	<i>60</i>	<i>90</i>			
<i>course sand</i>	<i>90</i>	<i>105</i>			

IF MORE SPACE IS NEEDED, USE BACK

If well telescopes please sketch and show depths.

---

GROUND LEVEL

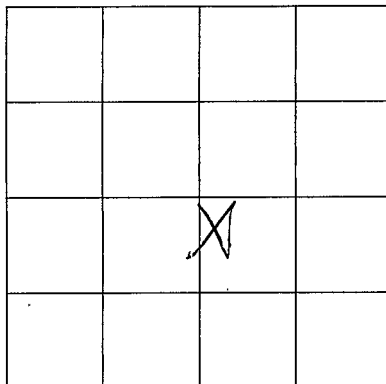

SECTION \_\_\_\_\_

Please indicate well location X.

---

ADDITIONAL INFORMATION

---

---

If more than one screen,  
show location of each on sketch.