

MISSISSIPPI DEPARTMENT OF ENVIRONMENTAL QUALITY

Office of Land and Water Resources

P. O. Box 10631
Jackson, MS 39289-0631
WATER WELL DRILLERS LOG

COUNTY WELL LOCATED <i>Lincoln</i>	
WELL NUMBER <i>2071</i>	CODED
DATE WELL COMPLETED <i>9-4-98</i>	

PERMIT NUMBER Green Water Well & Supply
NAME OF DRILLING FIRM 1218 Briarcliff Dr. SE Bogue Chitto, MS 39629

NAME & MAILING ADDRESS OF LANDOWNER <i>Robert Woodall</i>			
<i>1724 Bogue Chitto Rd</i>			
<i>Bogue Chitto MS</i>			
WELL LOCATION:	SEC <i>10</i>	TOWNSHIP <i>5 S</i>	RANGE <i>6 W</i>
DISTANCE <i>7</i> Miles	DIRECTION <i>W</i>	NEAREST TOWN <i>or Bogue Chitto</i>	
OTHER LANDMARK			
WELL PURPOSE (Home, Irrigation, Municipal, Industrial, Fish Pond, etc.)			

PUMP DATA		
PUMP TYPE (Circle One): Submersible, Turbine, Jet, Flowing Well, Other (Describe) _____		
POWER TYPE (Circle One): Electric, Tractor, Diesel, Gasoline, Butane, Other (Describe) _____		
Pump Capacity (GPM)	No. of Stages	Setting Depth _____ FT.
PUMP TEST		
Well yielded _____ GPM with a drawdown of _____ ft. after _____ hours of pumping		

WELL DATA		
Well Depth <i>100'</i>	Casing Diameter (In.) <i>4"</i>	Casing Length (Ft.) <i>90'</i>
Type of Casing <i>PVC</i>	Hole Depth <i>107'</i>	Depth to Static Water Level <i>46'</i>
TYPE OF COMPLETION: (Circle One or More): <input checked="" type="checkbox"/> Gravel Packed, <input type="checkbox"/> Underreamed, <input type="checkbox"/> Telescoped, <input type="checkbox"/> Natural Development, <input type="checkbox"/> Open Hole, <input type="checkbox"/> Other (Describe) _____		
WELL GROUTED TO A DEPTH OF <i>10</i> FEET Type Grout (circle one): Cement, Bentonite, or <input checked="" type="checkbox"/> Mix		

LOG DATA	
TYPE OF LOG RUN (Circle One): Electric, Gamma Ray, Density, Sonic, Neutron, Other (Describe) _____	
Name of Organization Running Log <i>No Log Run</i>	

SCREEN DATA		
Diameter - Inches <i>4"</i>	Length - Feet <i>10'</i>	Slot Size - Inches <i>.010</i>
Screen Type <i>PVC</i>	Depth to Bottom - Feet <i>100'</i>	

GEOLOGIC DATA (Office Use Only)			
Surface Elev.	Geologic Unit	Unit Thickness	Depth to Top
Subs. SWL	Date	Analysis	Aquifer Test
Driller's Remarks			
Top of Lap Pipe or Reduction in Casing			
FEET		IF TELESCOPED OR MORE THAN ONE SCREEN: USE BACK PAGE	

DESCRIPTION OF FORMATIONS ENCOUNTERED	FROM	TO
<i>Red Clay</i>	<i>0</i>	<i>10</i>
<i>Fine Sand</i>	<i>10</i>	<i>45</i>
<i>Sand & Gravel</i>	<i>45</i>	<i>103</i>
<i>White Clay</i>	<i>103</i>	<i>107</i>

FORMATIONS (Continued)	FROM	TO
RECEIVED		
JAN 25 1999		
Dept of Environmental Quality Office of Land & Water Resources		

IF MORE SPACE IS NEEDED, USE BACK

If well telescopes please sketch and show depths.


GROUND LEVEL

			X

SECTION 10

Please indicate well location X.

ADDITIONAL INFORMATION

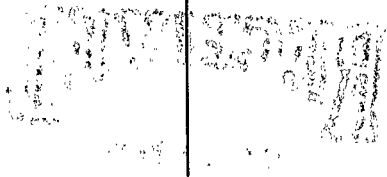

If more than one screen,
show location of each on sketch.