

**MISSISSIPPI DEPARTMENT OF ENVIRONMENTAL QUALITY**

Office of Land and Water Resources

P. O. Box 10631  
Jackson, MS 39289-0631  
**WATER WELL DRILLERS LOG**

COUNTY WELL LOCATED <i>Lincob</i>	
WELL NUMBER <i>CP</i>	CODED <i>2073</i>
DATE WELL COMPLETED <i>6-22-98</i>	

PERMIT NUMBER <b>Green Water Well &amp; Supply</b>
NAME OF DRILLER <b>1215 Providence Dr. SE Bogue Chitto, MS 39629</b>

NAME & MAILING ADDRESS OF LANDOWNER <i>Ella Mae Cook (Lenox)</i>			
<i>1547 Bogue Chitto Rd</i>			
<i>Bogue Chitto</i>			
WELL LOCATION:	SEC <i>11</i>	TOWNSHIP <i>5</i>	RANGE <i>6</i> <sup>E</sup> / <sub>W</sub>
DISTANCE <i>1</i> Miles	DIRECTION <i>W</i>	NEAREST TOWN <i>Arlington</i>	
OTHER LANDMARK			
WELL PURPOSE <input checked="" type="checkbox"/> Home <input type="checkbox"/> Irrigation, Municipal, Industrial, Fish Pond, etc.			

<b>PUMP DATA</b>		
PUMP TYPE (Circle One): <input checked="" type="checkbox"/> Submersible, <input type="checkbox"/> Turbine, <input type="checkbox"/> Jet, <input type="checkbox"/> Flowing Well, Other (Describe) _____		
POWER TYPE (Circle One): <input checked="" type="checkbox"/> Electric, <input type="checkbox"/> Tractor, <input type="checkbox"/> Diesel, <input type="checkbox"/> Gasoline, <input type="checkbox"/> Butane, Other (Describe) _____ H/P <i>1/2</i>		
Pump Capacity (GPM) <i>10</i>	No. of Stages <i>9</i>	Setting Depth <i>80'</i> FT.
PUMP TEST		
Well yielded <i>10</i> GPM with a drawdown of <i>10</i> ft. after <i>1</i> hours of pumping		

<b>WELL DATA</b>		
Well Depth <i>100'</i>	Casing Diameter (In.) <i>4"</i>	Casing Length (Ft.) <i>90'</i>
Type of Casing <i>PVC</i>	Hole Depth <i>108'</i>	Depth to Static Water Level <i>58'</i>

<b>LOG DATA</b>	
TYPE OF LOG RUN (Circle One): <input checked="" type="checkbox"/> No Log Run Electric, Gamma Ray, Density, Sonic, Neutron, Other (Describe) _____	
Name of Organization Running Log	

TYPE OF COMPLETION: (Circle One or More):  
 Gravel Packed,  Underreamed,  Telescoped,  
 Natural Development,  Open Hole,  Other  
(Describe) \_\_\_\_\_

WELL GROUTED TO A DEPTH OF *10* FEET  
Type Grout (circle one): Cement, Bentonite, or  Mix

<b>SCREEN DATA</b>		
Diameter - Inches <i>4"</i>	Length - Feet <i>10'</i>	Slot Size - Inches <i>.010</i>
Screen Type <i>PVC</i>	Depth to Bottom - Feet. <i>100'</i>	

<b>GEOLOGIC DATA (Office Use Only)</b>			
Surface Elev.	Geologic Unit	Unit Thickness	Depth to Top
Subs. SWL	Date	Analysis	Aquifer Test
Driller's Remarks			
Top of Lap Pipe or Reduction in Casing			
FEET		IF TELESCOPED OR MORE THAN ONE SCREEN: USE BACK PAGE	

DESCRIPTION OF FORMATIONS ENCOUNTERED	FROM	TO
<i>Red Clay</i>	<i>0</i>	<i>28</i>
<i>Red Sand</i>	<i>28</i>	<i>30</i>
<i>Gravel / Sand</i>	<i>30</i>	<i>100</i>
<i>White Clay</i>	<i>100</i>	<i>108</i>

FORMATIONS (Continued)	FROM	TO
<b>RECEIVED</b>		
<b>JAN 25 1999</b>		
Dept. of Environmental Quality Office of Land & Water Resources		

IF MORE SPACE IS NEEDED, USE BACK

If well telescopes please  
sketch and show depths.


GROUND LEVEL

			X

SECTION 11

Please indicate well location X.

ADDITIONAL INFORMATION

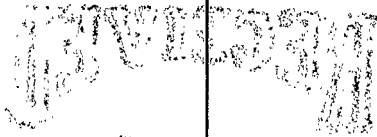

If more than one screen,  
show location of each on sketch.