

### MISSISSIPPI DEPARTMENT OF ENVIRONMENTAL QUALITY

Office of Land and Water Resources

P. O. Box 10631  
 Jackson, MS 39289-0631  
**WATER WELL DRILLERS LOG**

COUNTY WELL LOCATED	
Licoim	
WELL NUMBER	CODED
<b>2082</b>	
DATE WELL COMPLETED	
3-13-00	

PERMIT NUMBER
NAME OF DRILLING FIRM
<u>Algeria Well Service</u>

NAME & MAILING ADDRESS OF LANDOWNER		
<u>Howard Hall</u>		
<u>1520</u>		
WELL LOCATION: SEC _____ TOWNSHIP _____ RANGE _____		
<u>2 5 N 6 E</u>		
DISTANCE _____ Miles	DIRECTION _____	NEAREST TOWN _____
<u>6</u>	<u>West</u>	<u>Bozoth</u>
OTHER LANDMARK		
WELL PURPOSE <u>Home</u> , Irrigation, Municipal, Industrial, Fish Pond, etc.		

PUMP DATA		
PUMP TYPE (Circle One): Submersible, Turbine, Jet, Flowing Well, Other (Describe) _____		
POWER TYPE (Circle One): Electric, Tractor, Diesel, Gasoline, Butane, Other (Describe) _____ H/P _____		
Pump Capacity (GPM)	No. of Stages	Setting Depth FT.
PUMP TEST		
Well yielded _____ GPM with		
a drawdown of _____ ft.		
after _____ hours of pumping		

WELL DATA		
Well Depth	Casing Diameter (In.)	Casing Length (Ft.)
<u>98'</u>	<u>4"</u>	<u>88'</u>
Type of Casing	Hole Depth	Depth to Static Water Level
<u>RVC</u>	<u>98'</u>	<u>35'</u>
TYPE OF COMPLETION: (Circle One or More): <input checked="" type="checkbox"/> Gravel Packed, <input type="checkbox"/> Underreamed, <input type="checkbox"/> Telescoped, <input type="checkbox"/> Natural Development, <input type="checkbox"/> Open Hole, <input type="checkbox"/> Other (Describe) _____		
WELL GROUTED TO A DEPTH OF <u>10</u> FEET		
Type Grout (circle one): Cement, Bentonite, <u>Mix</u>		

LOG DATA	
TYPE OF LOG RUN (Circle One): Electric, Gamma Ray, Density, Sonic, Neutron, Other (Describe) _____	
Name of Organization Running Log	

SCREEN DATA		
Diameter - Inches	Length - Feet	Slot Size - Inches
<u>4"</u>	<u>10'</u>	<u>.012</u>
Screen Type	Depth to Bottom - Feet	
<u>RVC</u>	<u>98'</u>	


GEOLOGIC DATA (Office Use Only)			
Surface Elev.	Geologic Unit	Unit Thickness	Depth to Top
Subs. SWL	Date	Analysis	Aquifer Test
Driller's Remarks			
Top of Lap Pipe or Reduction in Casing			
FEET IF TELESCOPED OR MORE THAN ONE SCREEN: USE BACK PAGE			

DESCRIPTION OF FORMATIONS ENCOUNTERED	FROM	TO	FORMATIONS (Continued)	FROM	TO
<u>Top Soil</u>	<u>0</u>	<u>5</u>			
<u>clay</u>	<u>5</u>	<u>20</u>			
<u>Sand &amp; gravel</u>	<u>20</u>	<u>60</u>			
<u>clay</u>	<u>60</u>	<u>70</u>			
<u>Sand</u>	<u>70</u>	<u>80</u>			
<u>Coarse Sand</u>	<u>80</u>	<u>98</u>			

**REC'D JUN 21 2001**

If well telescopes please  
sketch and show depths.

GROUND LEVEL

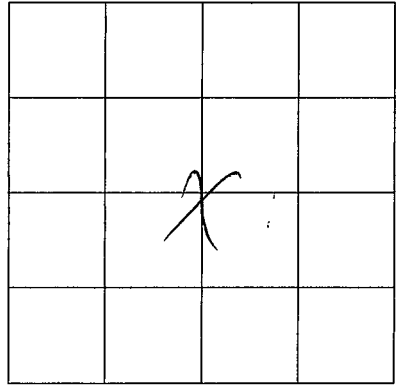

SECTION 2

Please indicate well location X.

ADDITIONAL INFORMATION

A series of horizontal lines for providing additional information.

If more than one screen,  
show location of each on sketch.