

MISSISSIPPI DEPARTMENT OF ENVIRONMENTAL QUALITY

Office of Land and Water Resources

P. O. Box 10631
Jackson, MS 39289-0631

WATER WELL DRILLERS LOG

COUNTY WELL LOCATED
Lincoln

WELL NUMBER <u>Ø-2085</u>	CODED
------------------------------	-------

DATE WELL COMPLETED
3/7/02

PERMIT NUMBER
Gretn Water Well & Supply

NAME OF DRILLING FIRM
1315 Pinedale Dr. SE
Bogue Chitto, MS 39029

NAME & MAILING ADDRESS OF LANDOWNER
Ben Sills

1708 Bogue Chitto Rd, Bogue Chitto

Latitude:
Longitude:

WELL LOCATION	SEC	TOWNSHIP	RANGE
	<u>3</u>	<u>5</u> ^N / _S	<u>6</u> ^E / _W

DISTANCE: 10 Miles DIRECTION: SW NEAREST TOWN: Brookhaven

OTHER LANDMARK

WELL PURPOSE (Home Irrigation, Municipal, Industrial, Fish Pond, etc.)

PUMP DATA

PUMP TYPE (Circle One):
Submersible Turbine Jet Flowing Well,
Other (Describe)

POWER TYPE (Circle One):
Electric Tractor Diesel Gasoline Butane
Other (Describe) H/P

DESCRIPTION OF FORMATIONS ENCOUNTERED	FROM	TO
<u>Red Clay</u>	<u>0</u>	<u>7</u>
<u>Sand & Gravel</u>	<u>7</u>	<u>140</u>

RECEIVED

APR 22 2002

BY: OLWR

Top of Lap Pipe or Reduction in Casing

FEET	IF TELESCOPED OR MORE THAN ONE SCREEN: USE BACK PAGE
------	--

WELL DATA

Well Depth <u>126</u>	Casing Diameter (In.) <u>4</u>	Casing Length (Ft.) <u>116</u>
Type of Casing <u>PVC</u>	Hole Depth <u>140</u>	Depth to Static Water Level <u>60</u>

TYPE OF COMPLETION: (Circle One or More):
Gravel Packed, Underreamed, Telescoped,
Natural Development, Open Hole, Other (Describe)

WELL GROUTED TO A DEPTH OF 10 FEET
Type Grout (circle one): Cement, Bentonite, or Mix

SCREEN DATA

Diameter - Inches <u>4</u>	Length - Feet <u>10</u>	Slot Size - Inches <u>.010</u>
Screen Type <u>PVC</u>	Depth to Bottom - Feet <u>126</u>	


I certify that the well was drilled, constructed and completed in accordance with all applicable Requirements of the Mississippi Department of Environmental Quality and/or the Mississippi Department of Health regulations and state laws.

Brian McClendon 0-664
Signature of Licensed Driller and License No.

_____ Date

If well telescopes please sketch and show depths.

GROUND LEVEL

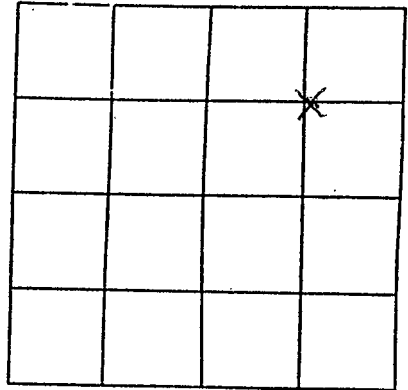

SECTION 3

Please indicate well location X.

Pump Capacity (GPM)	No. of Stages	Setting Depth	FT.
---------------------	---------------	---------------	-----

PUMP TEST

~~Well yielded _____ GPM with a drawdown of _____ ft. after _____ hours of pumping~~

LOG DATA

TYPE OF LOG RUN (Circle One): No Log Run.
 Electric, Gamma Ray, Density, Sonic, Neutron, Other (Describe) _____

Name of Organization Running Log _____

GEOLOGIC DATA (Office Use Only)

Surface Elev.	Geologic Unit	Unit Thickness	Depth to Top
Subs. SWL	Date	Analysis	Aquifer Test

Driller's Remarks

If more than one screen, show location of each on sketch.