

MISSISSIPPI DEPARTMENT OF ENVIRONMENTAL QUALITY

Office of Land and Water Resources

P. O. Box 10631
Jackson, MS 39289-0631
WATER WELL DRILLERS LOG

| | |
|---------------------------------------|-------|
| COUNTY WELL LOCATED <i>Lincoln</i> | |
| WELL NUMBER <i>Ø-2086</i> | CODED |
| DATE WELL COMPLETED <i>9/14/01</i> | |

| |
|--|
| PERMIT NUMBER <i>Well & Supply</i> |
| <i>1316 Pricedale Dr. SE</i> |
| NAME OF DRILLING FIRM <i>Boque Chitto, MS 39629</i> |

| | | |
|---|-----------|------------------------|
| NAME & MAILING ADDRESS OF LANDOWNER <i>Ratlie Noak</i> | | |
| <i>1962 Arlington Rd., Bogue Chitto</i> | | |
| Latitude: Longitude: | | |
| WELL LOCATION | SEC | TOWNSHIP |
| | <i>1</i> | <i>5</i> |
| | | <i>6</i> |
| | | <i>W</i> |
| DISTANCE | DIRECTION | NEAREST TOWN |
| <i>4</i> | <i>W</i> | <i>of Bogue Chitto</i> |
| OTHER LANDMARK | | |
| WELL PURPOSE: <input checked="" type="radio"/> Home, <input type="radio"/> Irrigation, <input type="radio"/> Municipal, <input type="radio"/> Industrial, <input type="radio"/> Fish Pond, etc. | | |

| | |
|--|---|
| PUMP DATA | |
| PUMP TYPE (Circle One): | |
| <input type="radio"/> Submersible, | <input type="radio"/> Turbine, |
| <input type="radio"/> Other (Describe) | <input type="radio"/> Jet <input type="radio"/> Flowing Well, |
| POWER TYPE (Circle One): | |
| <input checked="" type="radio"/> Electric, | <input type="radio"/> Tractor, |
| <input type="radio"/> Other (Describe) | <input type="radio"/> Diesel, |
| | <input type="radio"/> Gasoline, <input type="radio"/> Butane, |
| | <input type="radio"/> H/P |

| DESCRIPTION OF FORMATIONS ENCOUNTERED | FROM | TO |
|---------------------------------------|------------|------------|
| <i>Red Clay</i> | <i>0</i> | <i>23</i> |
| <i>Streaky</i> | <i>23</i> | <i>70</i> |
| <i>Sand & gravel</i> | <i>70</i> | <i>147</i> |
| <i>White Clay</i> | <i>147</i> | <i>150</i> |
| | | |
| | | |
RECEIVED
APR 22 2002
BY: OLWR

| | | |
|---|------------------------------------|--|
| WELL DATA | | |
| Well Depth <i>143</i> | Casing Diameter (In.) <i>4</i> | Casing Length (Ft.) <i>133</i> |
| Type of Casing <i>PVC</i> | Hole Depth <i>150'</i> | Depth to Static Water Level <i>75</i> |
| TYPE OF COMPLETION: (Circle One or More): | | |
| <input checked="" type="radio"/> Gravel Packed, | <input type="radio"/> Underreamed, | <input type="radio"/> Telescoped, |
| <input type="radio"/> Natural Development, | <input type="radio"/> Open Hole, | <input type="radio"/> Other |
| (Describe) | | |
| WELL GROUTED TO A DEPTH OF <i>10</i> FEET | | |
| Type Grout (circle one): Cement, Bentonite, or <input checked="" type="radio"/> Mix | | |

| | | |
|-------------------------------|--------------------------------------|-----------------------------------|
| SCREEN DATA | | |
| Diameter - Inches <i>4</i> | Length - Feet <i>10</i> | Slot Size - Inches <i>.010</i> |
| Screen Type <i>PVC</i> | Depth to Bottom - Feet <i>143</i> | |

| |
|--|
| Top of Lap Pipe or Reduction in Casing |
| FEET |

IF TELESCOPED OR MORE THAN ONE SCREEN: USE BACK PAGE


I certify that the well was drilled, constructed and completed in accordance with all applicable Requirements of the Mississippi Department of Environmental Quality and/or the Mississippi Department of Health regulations and state laws.

Brian McClellan 10-664
Signature of Licensed Driller and License No. *9/14/01*
Date

Additional Information Required On Back

If well telescopes please sketch and show depths.

GROUND LEVEL

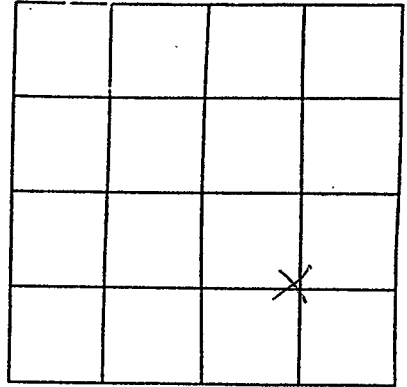

SECTION 1

Please indicate well location X.

| | | | |
|--|---------------|---------------|-----|
| Pump Capacity (GPM) | No. of Stages | Setting Depth | FT. |
| PUMP TEST | | | |
| Well yielded _____ GPM with a drawdown of _____ ft. after _____ hours of pumping | | | |

LOG DATA

TYPE OF LOG RUN (Circle One): No Log Run
 Electric, Gamma Ray, Density, Sonic, Neutron,
 Other (Describe) _____

Name of Organization Running Log _____

GEOLOGIC DATA (Office Use Only)

| Surface Elev. | Geologic Unit | Unit Thickness | Depth to Top |
|---------------|---------------|----------------|--------------|
| Subs. SWL | Date | Analysis | Aquifer Test |

Driller's Remarks

If more than one screen,
show location of each on sketch.