

Lincoln  
 P2  
 CODED  
 5-67

MISSISSIPPI  
 BOARD OF WATER COMMISSIONERS  
 416 North State Street  
 Jackson, Mississippi 39201

WATER WELL DRILLERS LOG

May 16 1967 Reeves well Drump Lincoln  
 date well completed firm name county well located

LANDOWNER: Melvin  
 Reeves  
 RFD Boguchitto  
 (mailing address)

WELL LOCATION:  
 sec. 16 T 5 N R 7 E  
 3/4 miles S.W. of Poplar  
 (distance) (direction) (nearest town)


WELL PURPOSE: Domestic  
 (home, irrigation, municipal, industrial)

WELL COMPLETION DATA:

- (1) diameter (inches) 4 1/5
- (2) total depth (feet) 115
- (3) static water level (feet) 77 below above top of ground.
- (4) casing Plastic bottom (material) (depth)
- (size) if telescope see back.
- (5) screen 6' 100' (length) (depth to top)  
 4" Plastic (size) (material)
- (6) pump 3/4 sub 15 (HP) (yield gpm)  
 elec (type power)
- (7) electric log No (yes or no)
- (organization running log)
- (8) how well bottom plugged wood plug.

description of formations encountered	from	to
clay gravel	0	22
Red Sand & gravel	22	67
Brown gravel with sand	67	85
Coarse Sand	85	115


CODED

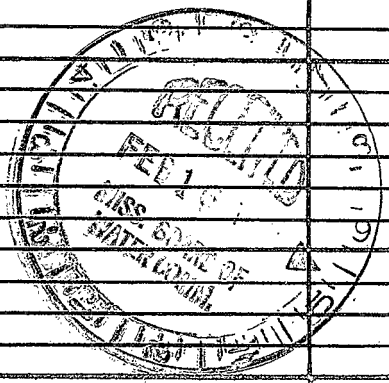

DRILLERS REMARKS:  
 new home.

If well telescopes please sketch and show depths.

GROUND LEVEL

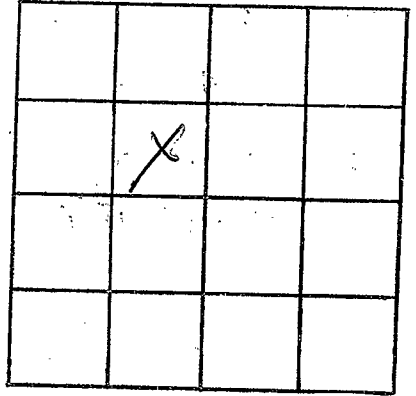

SECTION 16

Please indicate well location X.

ADDITIONAL INFORMATION

If more than one screen, show locations of each on sketch.