

LINCOLN MISSISSIPPI BOARD OF WATER COMMISSIONERS

P3

2-21-66 WATER WELL DRILLERS LOG

Date: 2-21, 1966 CODED, Driller: J. T. Cwington, Bon County, Pida
(Name)


(1) Owner of Land: Bill Derman
(Name)
Rt. 3 Bezing Clitto
(Address)
(2) Location: 1/4, 1/4, Sec. 6 T4R7
16 miles N 1/4 W of Summit
(distance) (direction) (Nearest Town)
(3) Topography: Hilly
(Hilly) (Flat) (Level)
(4) Purpose of Well: Domestic
(Domestic Irrigation
Municipal, Industrial, Other)

Description & Color of Materials Sand, Clay, Red Clay, Shell, etc.	Thick- ness Feet	Depth Feet
Sandy Clay	18	18
Clay	7	25
Clay	10	35
Clay	30	65
Clay	6	70
Clay	18	88

Information upon completion of well:

(1) Diameter 4" inches.
(2) Total Depth 88' feet.
(3) Water Level 25' feet below top of ground.
(4) Cased to 88', Size 4"
(5) Screen: Size 4", Length 6'
(6) Were any formations sealed against pollution?
yes, no.

CODED

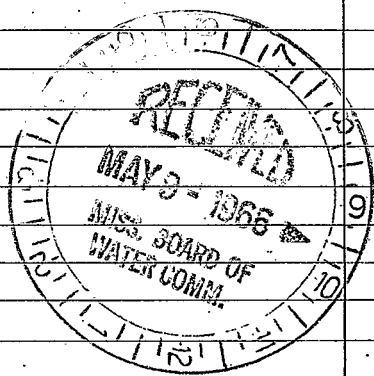

If YES depth of formation _____
Why _____
Drillers Remarks: _____

(Use Back Side)

Well No.

