

Lincoln

74 CODED

2-67

MISSISSIPPI BOARD OF WATER COMMISSIONERS  
416 North State Street  
Jackson, Mississippi 39201

WATER WELL DRILLERS LOG

Feb 1 1967 date well completed  
Adair's Drilling Co. firm name  
Lincoln county well located

LANDOWNER: Sidney Little  
513 Hillcrest  
W<sup>c</sup> Comb, Miss  
(mailing address)

description of formations encountered	from	to
<u>Red Clay</u>	<u>0'</u>	<u>20'</u>
<u>gravel</u>	<u>20'</u>	<u>40'</u>
<u>Coarse sand/gravel</u>	<u>40'</u>	<u>60'</u>

WELL LOCATION:  
sec 33 T 5 N R 2 E  
4 miles N-W of Summit  
(distance) (direction) (nearest town)

WELL PURPOSE: Home  
(home, irrigation, municipal, industrial)


WELL COMPLETION DATA:

- (1) diameter (inches) 4"
- (2) total depth (feet) 64'
- (3) static water level (feet) 39' below above-top of ground.
- (4) casing Plastic, 58',  
(material) (depth)  
4"  
(size) If telescope see back.
- (5) screen 6', 64'  
(length) (depth to top)  
4", Plastic P.V.C.  
(size) (material)
- (6) pump 8  
(HP) (yield gpm)  
  
(type power)
- (7) electric log NO  
(yes or no)  
  
(organization running log)
- (8) how well bottom plugged Back  
Wash Valve

CODED


DRILLERS REMARKS:

Bucket Well

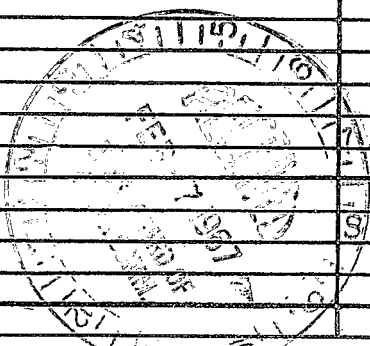

If well telescopes please sketch and show depths.

GROUND LEVEL

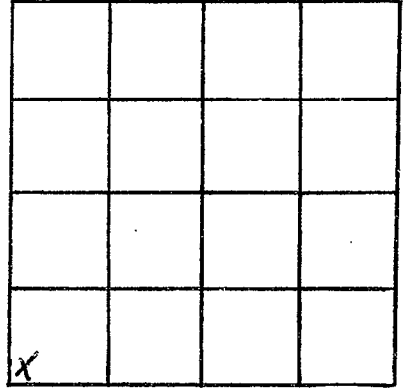

SECTION 33

Please indicate well location X.

ADDITIONAL INFORMATION

If more than one screen, show locations of each on sketch.