

Lincoln
P5
12-67

MISSISSIPPI
BOARD OF WATER COMMISSIONERS
416 North State Street
Jackson, Mississippi 39201

CODED

WATER WELL DRILLERS LOG

12-1-67 date well completed
167 Fitzgerald Water Well firm name
Lincoln county well located

LANDOWNER: Hansel Moore

Summit Miss Rt

(mailing address)

WELL LOCATION:

sec 28 T 5 N R 7 E
S W
5 miles W of Summit
(distance) (direction) (nearest town)

WELL PURPOSE: Home
(home, irrigation, municipal, industrial)

WELL COMPLETION DATA:

- (1) diameter (inches) 4
- (2) total depth (feet) 77
- (3) static water level (feet) 45 below top of ground
- (4) casing plastic 71 (material) (depth)
if telescope see back.
(size)
- (5) screen 6' 71 (length) (depth to top)
4 plastic (size) (material)
- (6) pump (HP) (yield gpm)
Eloc (type power)
- (7) electric log NO (yes or no)

(organization running log)

(8) how well bottom plugged Mud bog

DRILLERS REMARKS:


description of formations encountered

from to

Topsoil + Red Clay 0 10
Red Sand 10 35
Gravel - 35 77

Chalk

CODED

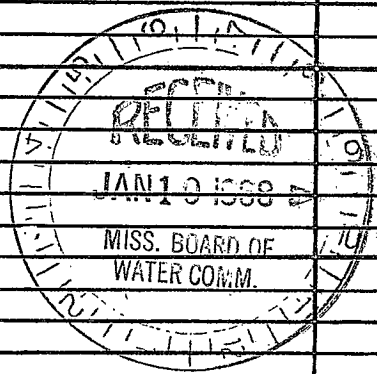

If well telescopes please sketch and show depths.

GROUND LEVEL

			X

SECTION 28

Please indicate well location X.

ADDITIONAL INFORMATION

If more than one screen, show locations of each on sketch.