

Lincoln
P6
1-68

MISSISSIPPI
BOARD OF WATER COMMISSIONERS
416 North State Street
Jackson, Mississippi 39201

CODED

CODED WATER WELL DRILLERS LOG

Jan 19 1968 Fitzgerald Well Serv. Lincoln
date well completed firm name county well located

LANDOWNER: William Freeman
RR - Summit miss.
(mailing address)

description of formations encountered	from	to
<u>Red clay</u>	<u>0</u>	<u>20</u>
<u>Red sand</u>	<u>20</u>	<u>70</u>
<u>Coarse sand & gravel</u>	<u>70</u>	<u>82</u>


WELL LOCATION:
sec. 34 T 5 N R 7 E
6' miles NNW of Summit
(distance) (direction) (nearest town)

WELL PURPOSE: Home
(home, irrigation, municipal, industrial)

- WELL COMPLETION DATA:
- (1) diameter (inches) 4
 - (2) total depth (feet) 82
 - (3) static water level (feet) 55 below top of ground.
 - (4) casing Plastic 76' (material) (depth)
4" if telescope see back. (size)
 - (5) screen 6' (length) 76' (depth to top)
4" (size) Plastic (material)
 - (6) pump 7 (HP) 7 (yield gpm)
Alu (type power)
 - (7) electric log no (yes or no)
(organization running log)
 - (8) how well bottom plugged wood plug


CODED

DRILLERS REMARKS:

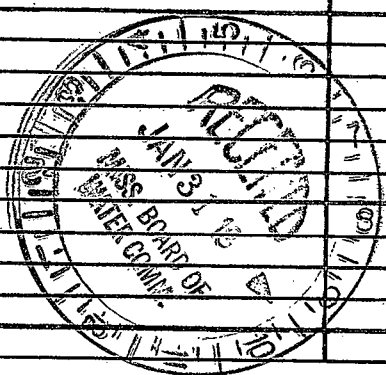

If well telescopes please sketch and show depths.

GROUND LEVEL

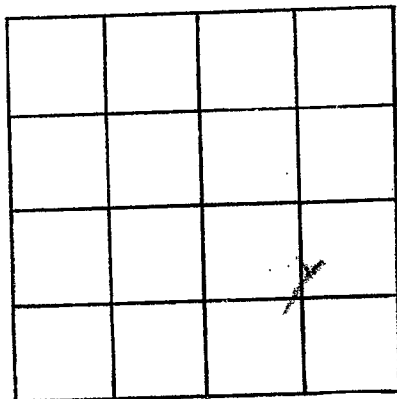

SECTION 34

Please indicate well location X.

ADDITIONAL INFORMATION

If more than one screen, show locations of each on sketch.