

P10 OKger 10/17/68

~~PIKE~~ Lincoln P10

CODED

WATER WELL DRILLERS LOG

CODED


Date: 9-20, 1963, Driller: Chester Deane Lincoln County

- (1) Owner of Land: Johnny Brown (Name)
RFD, Boguclitto (Address)
- (2) Location: 1/4, 1/4, Sec. 22 NE 5 R. 7
3 miles North W. of Summit (distance) (direction) (Nearest Town)
- (3) Topography: Hilly (Hilly) (Flat) (Level)
- (4) Purpose of Well: Domestic (Domestic Irrigation, Municipal, Industrial, Other)

Description & Color of Materials Sand, Clay, Red Clay, Shell, etc.	Thick- ness Feet	Dep Feet
TOP clay	10	10
yellow sand	44	54
sand & gravel	10	64

Information upon completion of well:

- (1) Diameter 4 inches.
- (2) Total Depth 64 feet.
- (3) Water Level 40 feet below top of ground.
- (4) Cased to bottom Size 4
- (5) Screen: Size 4", Length 5'
- (6) Were any formations sealed against pollution?
yes, no.

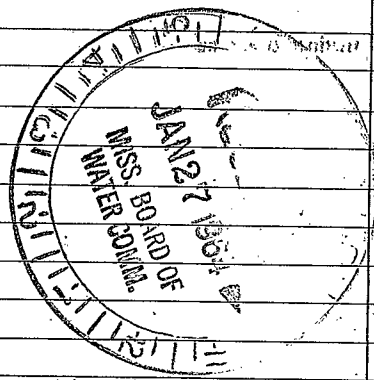

CODED

Cannot locate. RN

If YES depth of formation

Why

Drillers' Remrks: old well Bad.

REEVES WELL & PUMP CO. P. O. BOX 71 - PHONE 684-1451 McCOMB, MISS.

(Use Back-Side)

Well No.

WATER WELL DRILLERS LOG

Date: _____, 19____, Driller: _____ County _____

(Name)

	Description & Color of Materials Sand, Clay, Red Clay, Shell, etc.	Thick- ness Feet	Depth Feet
(1) Owner of Land: _____ (Name)			
(Address)			
(2) Location: _____ ¼, _____ ¼, Sec. _____ T. R. _____ _____ miles _____ of _____ (distance) (direction) (Nearest Town)			
(3) Topography: _____ (Hilly) (Flat) (Level)			
(4) Purpose of Well: _____ (Domestic irrigation Municipal, Industrial, Other)			
Information upon completion of well:			
(1) Diameter _____ inches.			
(2) Total Depth _____ feet.			
(3) Water Level _____ feet below top of ground.			
(4) Cased to _____, Size _____			
(5) Screen: Size _____, Length _____			
(6) Were any formations sealed against pollution? _____ yes, _____ no.			
If YES depth of formation _____			
Why _____			
Drillers Remarks: _____			

(Use Back Side)

Well No.

Retain this copy for your office files.