

CODED

MISSISSIPPI
BOARD OF WATER COMMISSIONERS
416 North State Street
Jackson, Mississippi 39201

WATER WELL DRILLERS LOG

Lucas
P 11
5-68

May 29 19*68* *Kenneth Pump* *Lucas*
date well completed firm name county well located

LANDOWNER: *James Freeman RFD Summit*
(mailing address)

description of formations encountered	from	to
<i>clay</i>	<i>0</i>	<i>8</i>
<i>sand</i>	<i>8</i>	<i>140</i>
<i>clay</i>	<i>140</i>	<i>50</i>
<i>small gravel sand</i>	<i>50</i>	<i>67</i>

WELL LOCATION:
sec *33* T. *S* N R. *7* E
5 miles *NNW* of _____
(distance) (direction) (nearest town)

WELL PURPOSE: *Home*
(home, irrigation, municipal, industrial)


WELL COMPLETION DATA:

- (1) diameter (inches) *4"*
- (2) total depth (feet) *67 ft.*
- (3) static water level (feet) *17* below above top of ground.
- (4) casing *plastic ballon*
(material) (depth)
- (size) If telescope see back.
- (5) screen *6'* *56'*
(length) (depth to top)
- 4"* *plastic*
(size) (material)
- (6) pump *1/2 sub* *15*
(HP) (yield gpm)
- (type power)
- (7) electric log *no*
(yes or no)
- (organization running log)

corrected info 8/8/68


(8) how well bottom plugged
no plug

DRILLERS REMARKS:
New hand.

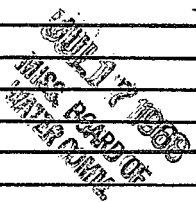

If well telescopes please sketch and show depths.

GROUND LEVEL

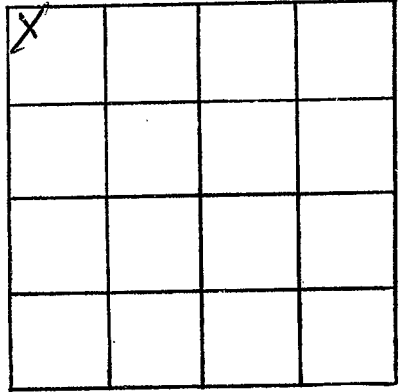

SECTION 3.3

Please indicate well location X.

ADDITIONAL INFORMATION

If more than one screen,
show locations of each on sketch.