

CODED

Lincoln  
P12  
8-68

MISSISSIPPI  
BOARD OF WATER COMMISSIONERS  
416 North State Street  
Jackson, Mississippi 39201

WATER WELL DRILLERS LOG

8-30 1968 Ed Fitzgerald Water Well Lincoln  
date well completed firm name county well located


LANDOWNER: Bert Welch  
Summit Pt MISS  
(mailing address)

description of fomations encountered	from	to
<u>top soil &amp; clay</u>	<u>0</u>	<u>20</u>
<u>Red sand</u>	<u>20</u>	<u>35</u>
<u>White chalk</u>	<u>35</u>	<u>95</u>
<u>sand</u>	<u>95</u>	<u>105</u>
<u>Blue Chalk</u>	<u>105</u>	<u>148</u>
<u>Sand &amp; gravel</u>	<u>148</u>	<u>158</u>

WELL LOCATION:  
sec 32 T 5 N 7 E  
S W  
5 miles NW of Summit  
(distance) (direction) (nearest town)

WELL PURPOSE: none  
(home, irrigation, municipal, industrial)


- WELL COMPLETION DATA:
- (1) diameter (inches) 4
  - (2) total depth (feet) 158
  - (3) static water level (feet) 80 below above top of ground.
  - (4) casing plastic 152  
(material) (depth)
  - 4 if telescope see back.  
(size)
  - (5) screen 6" 152  
(length) (depth to top)
  - 4 Schwo  
(size) (material)
  - (6) pump Eper  
(HP) (yield gpm)
  - (7) electric log no  
(yes or no)
  - (organization running log)
  - (8) how well bottom plugged plugged

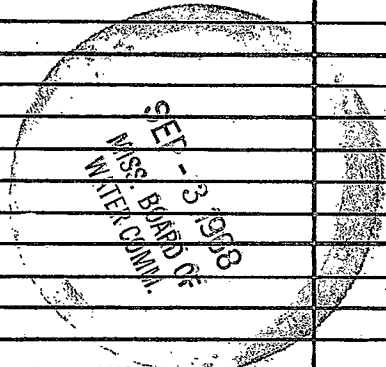

DRILLERS REMARKS:

If well telescopes please sketch and show depths.

GROUND LEVEL

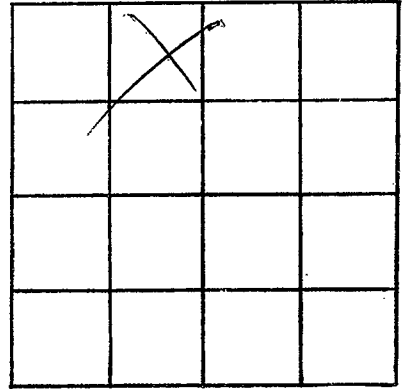

SECTION 32

Please indicate well location X.

ADDITIONAL INFORMATION

If more than one screen, show locations of each on sketch.