

CODED

Lincoln  
P14  
1-13-69

MISSISSIPPI  
BOARD OF WATER COMMISSIONERS  
416 North State Street  
Jackson, Mississippi 39201

CODED

WATER WELL DRILLERS LOG

Jan 13 1969 Reeves well & Pump Co. Lincoln  
date well completed firm name county well located

LANDOWNER: Clark Reeves  
P.D. Bogue Chitto  
(mailing address)

description of formations encountered	from	to
Red clay gravel	0	22
Brown Silty Sand	22	87
Hard blue chalk	87	273
Light blue sand	273	324
Blue chalk	324	331
Coarse sand	331	337
	337	336

WELL LOCATION:  
sec. 23 T 5 N R. 7 E  
2 miles S of Winfield  
(distance) (direction) (nearest town)

WELL PURPOSE: Home  
(home, irrigation, municipal, industrial)

- WELL COMPLETION DATA:
- (1) diameter (inches) 4"
  - (2) total depth (feet) 336
  - (3) static water level (feet) 44 <sup>below</sup> top of ground.
  - (4) casing Plastic Bottom  
(material) (depth)  
(size) if telescope see 2-10
  - (5) screen 10' Plastic  
(length) (depth to top)  
(size) (material)
  - (6) pump owner to install  
(HP) (rated gpm)  
(type power)
  - (7) electric log NO  
(yes or no)  
(organization running log)


(8) how well bottom plugged wooden plug  
DRILLERS REMARKS: New house

APR 22 1969

MISS. BD. OF  
WATER COMM.

If well telescopes please sketch and show depths.

GROUND LEVEL

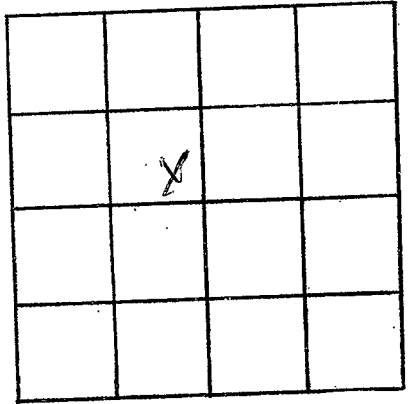

SECTION 23

Please indicate well location X.

ADDITIONAL INFORMATION

If more than one screen,  
show locations of each on sketch.