

CODED

9/22/69

OK 9/26/69

CODED

Lincoln
P 15
6-19-69

MISSISSIPPI
BOARD OF WATER COMMISSIONERS
416 North State Street
Jackson, Mississippi 39201

WATER WELL DRILLERS LOG

June 19, 1969 *Reese Well Drilling Co - Lincoln*
date well completed firm name county well located

LANDOWNER: *Miss. Betty Brown*
RFD Barkschott
(mailing address)

description of formations encountered	from	to
<i>clay</i>	<i>0</i>	<i>16</i>
<i>red sand</i>	<i>16</i>	<i>55</i>
<i>brwn sand & gravel</i>	<i>55</i>	<i>67</i>
<i>chalky sand</i>	<i>67</i>	<i>95</i>
<i>coarse sand</i>	<i>95</i>	<i>107</i>

WELL LOCATION:
sec *28* T *S* N *5* R *7* E
6 1/2 miles *N.W.* of *Summit*
(distance) (direction) (nearest town)

WELL PURPOSE: *Home*
(home, irrigation, municipal, industrial)

- WELL COMPLETION DATA:
- (1) diameter (inches) *4"*
 - (2) total depth (feet) *107*
 - (3) static water level (feet) *47* below top of ground.
 - (4) casing *Plastic bottom*
(material) (depth)
 - (size) if telescope see back.
 - (5) screen *6'* *101*
(length) (depth to top)
4" *Plastic*
(size) (material)
 - (6) pump *seddumphy*
(HP) (yield gpm)
owner
(type power)
 - (7) electric log *No*
(yes or no)
 - (organization running log)


(8) how well bottom plugged *wooden plug*

DRILLERS REMARKS:
New location for house well

MASS. REG. OF
WELLER BOARD

If well telescopes please sketch and show depths.

GROUND LEVEL

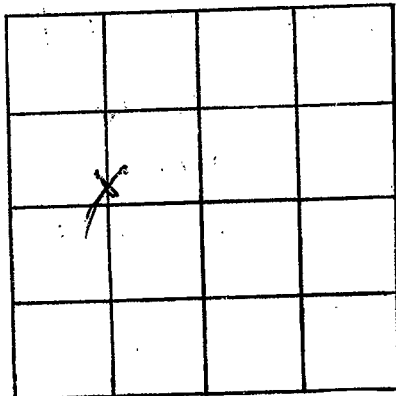

SECTION 28

Please indicate well location X.

ADDITIONAL INFORMATION

If more than one screen,
show locations of each on sketch.