

LINCOLN
P/6
10-28-69

MISSISSIPPI
 BOARD OF WATER COMMISSIONERS
 416 North State Street
 Jackson, Mississippi 39201

WATER WELL DRILLERS LOG

10-28 1969 Fitzgerald well Lincoln
 date well completed firm name county well located

LANDOWNER:
W. E. Bunt
RR. Boquechitto miss.
 (mailing address)

WELL LOCATION:
 sec. 6 T 5 N R 7 E
7 miles W of Boquechitto
 (distance) (direction) (nearest town)

description of formations encountered	from	to
<i>Red clay</i>	<i>0</i>	<i>20</i>
<i>Red sand</i>	<i>20</i>	<i>40</i>
<i>Coarse sand</i>	<i>40</i>	<i>50</i>
<i>white chalk</i>	<i>50</i>	<i>60</i>
<i>Coarse sand</i>	<i>60</i>	<i>78</i>

WELL PURPOSE: drinking
 (home, irrigation, municipal, industrial)

WELL COMPLETION DATA:

(1) diameter (inches) 4

(2) total depth (feet) 78

(3) static water level (feet) 30 below above top of ground.

(4) casing plastic, 72
 (material) (depth)
4 if telescope see back.
 (size)

(5) screen 6, 72
 (length) (depth to top)
4, plastic
 (size) (material)

(6) pump ?, ?
 (HP) (yield gpm)
?
 (type power)

(7) electric log no
 (yes or no)
 (organization running log)

(8) how well bottom plugged covered by


DRILLERS REMARKS:

NOV 21 1969

MISS. BD. OF
 WATER COM. LOG

If well telescopes please sketch and show depths.

GROUND LEVEL

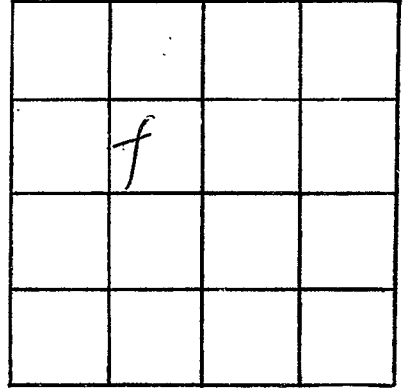

SECTION 6

Please indicate well location X.

ADDITIONAL INFORMATION

If more than one screen,
show locations of each on sketch.