

LINCOLN
P 17
1-17-70

MISSISSIPPI
BOARD OF WATER COMMISSIONERS
416 North State Street
Jackson, Mississippi 39201

CODI

WATER WELL DRILLERS LOG

17 Jan. 1970 J.T. Crayton & Son Lincoln
date well completed firm name county well located

LANDOWNER:	description of formations encountered	from	to
W.D. Powers Boquetite (mailing address)	Red clay Red silty sand sand	0 75 140 65	75 160 65 91
WELL LOCATION: sec. 11 T. 5 N R. 7 E 8 miles North of Summit (distance) (direction) (nearest town)			
WELL PURPOSE: (home, irrigation, municipal, industrial)			
WELL COMPLETION DATA:			
(1) diameter (inches) 4			
(2) total depth (feet) 91			
(3) static water level (feet) 60 below top of ground.			
(4) casing 4" (material), 91 (depth)			
if telescope see back.			
(5) screen 6 (length), 85 (depth to top)			
(6) pump 1/2 (HP), 10 (yield gpm)			
(7) electric log (yes or no)			
(organization running log)			
(8) how well bottom plugged wood			
DRILLERS REMARKS:			


CODI

FEB 16 1970

MISS. Bd. of
Water Comm.

If well telescopes please sketch and show depths.

GROUND LEVEL

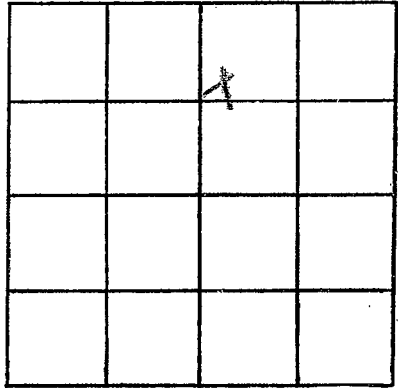

SECTION 11

Please indicate well location X.

ADDITIONAL INFORMATION

If more than one screen,
show locations of each on sketch.