

Lincoln Co

P 18

3-12-70

MISSISSIPPI BOARD OF WATER COMMISSIONERS
416 North State Street
Jackson, Mississippi 39201

CODED

WATER WELL DRILLERS LOG

Lincoln
Pike

17 March 1970
date well completed

J.T. Bevington
firm name

county well located

LANDOWNER:
John Smiley
(mailing address)

WELL LOCATION: 168
sec. 19 T. 5 N. R. 7 E
7 miles North of Summit
(distance) (direction) (nearest town)

description of formations encountered	from	to
Clay	0	10
Chalk & Clay	10	25
Good Chalk	25	60
Good	60	85
Chalk	85	90
Good Chalk	90	112

WELL PURPOSE: Home
(home, irrigation, municipal, industrial)

- WELL COMPLETION DATA:
- (1) diameter (inches) 4
 - (2) total depth (feet) 112
 - (3) static water level (feet) 80 below top of ground.
 - (4) casing PI (material) 106 (depth)
 - 4 (size) if telescope see back.
 - (5) screen 6 (length) 106 (depth to top)
 - 4 (size) PI (material)
 - (6) pump 1/2 (HP) 10 (yield gpm)
 - Elect (type power)
 - (7) electric log (yes or no)

(organization running log)

(8) how well bottom plugged wood


MAY 18 1970

DRILLERS REMARKS:

MISS. RD. OF WATER COMM.

If well telescopes please sketch and show depths.

GROUND LEVEL

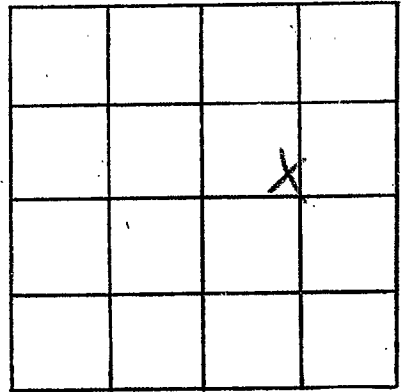

SECTION 19

Please indicate well location X.

ADDITIONAL INFORMATION

If more than one screen, show locations of each on sketch.