

Lincoln
P 20
6-15-70

MISSISSIPPI
BOARD OF WATER COMMISSIONERS
416 North State Street
Jackson, Mississippi 39201

CODED

WATER WELL DRILLERS LOG

June 15 19 70 Grenn Water Well Lincoln
date well completed firm name county well located

LANDOWNER:	description of formations encountered	from	to
<u>Loyce Howard</u> <u>Rt 5, Brookhaven</u> (mailing address)			

WELL LOCATION:
sec 20 T 5 N R 7 E
7 miles NW of Summit
(distance) (direction) (nearest town)

WELL PURPOSE: Home
(home, irrigation, municipal, industrial)

- WELL COMPLETION DATA:
- (1) diameter (inches) 6 in
 - (2) total depth (feet) 100
 - (3) static water level (feet) 35 below top of ground.
 - (4) casing PVC 892
(material) (depth)
 - (size) if telescope see back.
 - (5) screen 4 1/2 88
(length) (depth to top)
 - 1010 PVC
(size) (material)
 - (6) pump no
(HP) (yield gpm)
 - (type power)
 - (7) electric log no
(yes or no)
 - (organization running log)
 - (8) how well bottom plugged Wood

CODED


JUL 2 1970

DRILLERS REMARKS:

MISS. BD. OF
WATER COMMISSIONERS

If well telescopes please sketch and show depths.

GROUND LEVEL

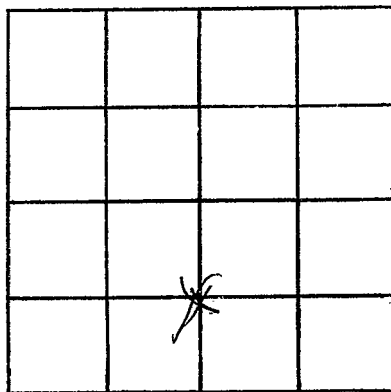

SECTION 20

Please indicate well location X.

ADDITIONAL INFORMATION

If more than one screen, show locations of each on sketch.