

LINCOLN
P 22
12-21-70

MISSISSIPPI
BOARD OF WATER COMMISSIONERS
416 North State Street
Jackson, Mississippi 39201

CODED

WATER WELL DRILLERS LOG

21 Dec 1970 S&P Water Well Lincoln
date well completed firm name county well located

LANDOWNER:

Ellis Jones

Summit
(mailing address)

WELL LOCATION:

sec. 36 T 5 N R 7 E
6 miles North of Summit
(distance) (direction) (nearest town)

WELL PURPOSE:

(home, irrigation, municipal, industrial)

WELL COMPLETION DATA:

- (1) diameter (inches) 4
- (2) total depth (feet) 112
- (3) static water level (feet) 80 below above top of ground.
- (4) casing 11, 106 (material) (depth)
(size) if telescope see back.
- (5) screen 6, 106 (length) (depth to top)
4, 11 (size) (material)
- (6) pump 1/2 (HP) 8 (yield gpm)
elect. (type power)
- (7) electric log (yes or no)

(organization running log)

- (8) how well bottom plugged *used*

description of formations encountered

from to

Clay	0	20
Chalky clay	20	65
5' sand chdk	65	70
3' sand	70	95
7' sand	95	112

CODED


JAN 19 1971

DRILLERS REMARKS:

MISC. DD. OF
WATER COMMISSIONERS

If well telescopes please sketch and show depths.

GROUND LEVEL

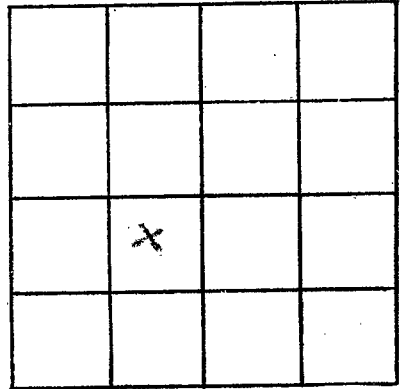

SECTION

Please indicate well location X.

ADDITIONAL INFORMATION

If more than one screen,
show locations of each on sketch.