

LINCOLN
P23
1-21-71

MISSISSIPPI
BOARD OF WATER COMMISSIONERS
416 North State Street
Jackson, Mississippi 39201

CODED 1971
FEB

MISS. BD. OF
WATER COMMISSIONERS

WATER WELL DRILLERS LOG

Jan 21 1971 date well completed
Chester Keener firm name
Lincoln county well located

LANDOWNER: William Balpan
PFD Some Chitto (mailing address)

description of formations encountered	from	to
Clay	0	13
Chalky sand	13	40
Sand & gravel	40	60
Chalk	60	70
Sandy chalk	70	75
Chalk	75	110
Sand & gravel	110	119

WELL LOCATION:
sec 31 T 5 N R 7 E
5 miles N.W. of Sumner (nearest town)

WELL PURPOSE: Home (home, irrigation, municipal, industrial)


- WELL COMPLETION DATA:
- (1) diameter (inches) 4"
 - (2) total depth (feet) 119
 - (3) static water level (feet) 75 below top of ground.
 - (4) casing: Plastic, Balpan (material) (depth)
 - (5) screen: 6' 113 (length) (depth to top)
4" (size) Plastic (material)
 - (6) pump: 1/2 HP (type power)
Sub. (yield gpm)
 - (7) electric log NO (yes or no)
 - (8) how well bottom plugged NO

CODED

DRILLERS REMARKS: well filled with sand.

If well telescopes please
sketch and show depths.

GROUND LEVEL

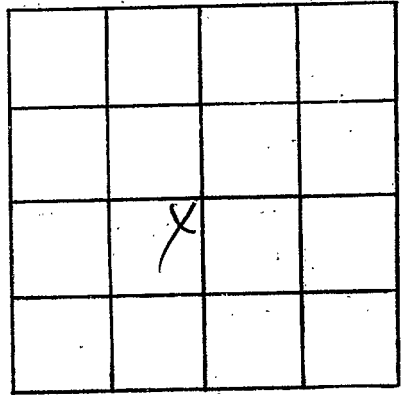

SECTION 31

Please indicate well location X.

ADDITIONAL INFORMATION

Lined area for additional information.

If more than one screen,
show locations of each on sketch.