

LINCOLN  
P 24  
3-31-71

MISSISSIPPI  
BOARD OF WATER COMMISSIONERS  
416 North State Street  
Jackson, Mississippi 39201

**CODED**

Lincoln  
Oke

WATER WELL DRILLERS LOG

March 31, 1971 date well completed  
Chester Reeves firm name  
Oke county well located

LANDOWNER: James Walker RFD Summit (mailing address)	description of formations encountered	from	to
	Clay	0	16
	red sand	16	55
	brown gravel-sand	55	68
	red chunky sand	68	84
	blue chunk	84	113
	Red gravel-sand	113	128

WELL LOCATION:	
sec <del>43</del> T <del>4</del> N R <del>7</del> E 4 1/2 miles NNW Summit (distance) (direction) (nearest town)	

WELL PURPOSE:	
Home - Laundry (home, irrigation, municipal, industrial)	

WELL COMPLETION DATA:	
(1) diameter (inches) 4"	
(2) total depth (feet) 128	
(3) static water level (feet) 59 below top of ground.	
(4) casing (material) Plast. batens (depth) (size) if telescope see back.	
(5) screen (length) 6' (depth to top) 122'	
(6) pump (size) 4" (material) Plast.	
(6) pump (HP) 3/4 sub 15 (yield gpm)	
(7) electric log (type power) Plast.	
(7) electric log (yes or no) no	
(organization running log)	
(8) how well bottom plugged washed	

DRILLERS REMARKS:	
old let pump and well not adequate	


**CODED**

MAY 23 1971

MISS. BD. OF  
WATER COM.

If well telescopes please sketch and show depths.

GROUND LEVEL

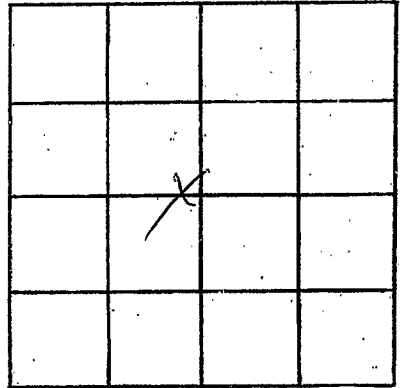

SECTION 33

Please indicate well location X.

ADDITIONAL INFORMATION

If more than one screen,  
show locations of each on sketch.