

LINCOLN

P 25

4-27-71

MISSISSIPPI BOARD OF WATER COMMISSIONERS
416 North State Street
Jackson, Mississippi 39201

CODED

WATER WELL DRILLERS LOG

April 27, 1971 date well completed
Chestertown firm name
Lincoln county well located

LANDOWNER: Arnye Reeves

description of formations encountered

from to

RFD.
Boque chitto
(mailing address)

Red clay
Red sand
Sand rocks
Sandy sand
Red gravel

0 17
17 68
68 76
76 107
107 115

WELL LOCATION:

sec. 5 T. 5 N. R. 7 E.
5 miles SW Boque chitto
(distance) (direction) (nearest town)

WELL PURPOSE: Home
(home, irrigation, municipal, industrial)

WELL COMPLETION DATA:

- (1) diameter (inches) 4"
- (2) total depth (feet) 115
- (3) static water level (feet) 62 below top of ground.
- (4) casing Plast Bottom
(material) (depth)
- (size) if telescope see back.
- (5) screen 6' 109
(length) (depth to top)
- (size) Plast
(material)
- (6) pump Bya 109
(HP) (yield gpm)
- (type power)
- (7) electric log NO
(yes or no)
- (organization running log)

CODED

(8) how well bottom plugged
woodruffing


DRILLERS REMARKS:
new location

MAY 20 1971

MISS. DEPT. OF WATER CONTROL

If well telescopes please sketch and show depths.

GROUND LEVEL

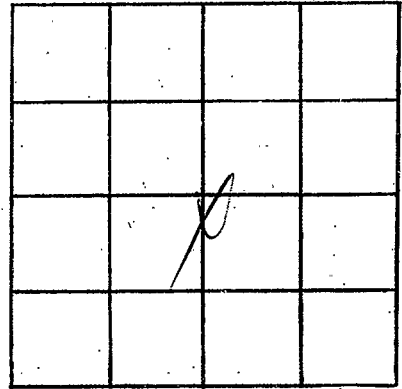

SECTION 9

Please indicate well location X.

ADDITIONAL INFORMATION

A series of horizontal lines for writing additional information, consisting of 18 lines.

If more than one screen, show locations of each on sketch.