

MISSISSIPPI
BOARD OF WATER COMMISSIONERS
416 North State Street
Jackson, Mississippi 39201

CODED

WATER WELL DRILLERS LOG

LINCOLN
P 26
6-3-71

3 June 1971 SRP Waterwell Lincoln
date well completed firm name county well located

LANDOWNER:
Robert Hill
Summit
(mailing address)

WELL LOCATION:
sec. 36 T 5 N R 7 E
6 miles NW of Summit
(distance) (direction) (nearest town)

description of formations encountered	from	to
<u>clay</u>	<u>0</u>	<u>15</u>
<u>red shaly</u>	<u>15</u>	<u>35</u>
<u>red chert</u>	<u>35</u>	<u>75</u>
<u>red chert</u>	<u>75</u>	<u>90</u>
<u>3rd</u>	<u>90</u>	<u>125</u>

WELL PURPOSE:
(home, irrigation, municipal, industrial)

WELL COMPLETION DATA:

(1) diameter (inches) 4

(2) total depth (feet) 126

(3) static water level (feet) 70 below above top of ground.

(4) casing PI 120
(material) (depth)
(size) if telescope see back.

(5) screen 6 120
(length) (depth to top)
4 PI
(size) (material)

(6) pump 1/2 8
(HP) (yield gpm)
Electric
(type power)

(7) electric log yes or no

CODED

(organization running log)

(8) how well bottom plugged wood


JUL 14 1971

DRILLERS REMARKS:

MISSISSIPPI
BOARD OF WATER
COMMISSIONERS

If well telescopes please sketch and show depths.

GROUND LEVEL

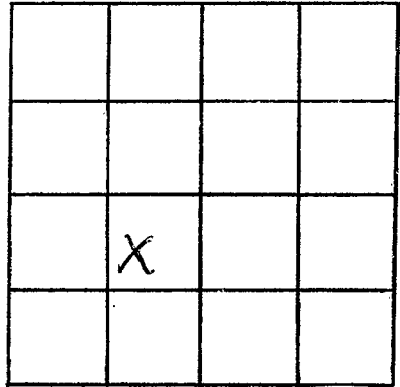

SECTION 36

Please indicate well location X.

ADDITIONAL INFORMATION

If more than one screen,
show locations of each on sketch.