

LINCOLN
P27
9-27-71

MISSISSIPPI
 BOARD OF WATER COMMISSIONERS
 416 North State Street
 Jackson, Mississippi 39201
 WATER WELL DRILLERS LOG

CODED

9-27 1971 Fitzgerald Lincoln
 date well completed firm name county well located

LANDOWNER:	description of formations encountered	from	to
<u>J. L. Dillon</u> <u>R.R. Summit over</u> (mailing address)			

WELL LOCATION:
 sec. 29 T. 5 N. R. 2 E.
S
5 miles NNW of Summit
 (distance) (direction) (nearest town)

WELL PURPOSE: domestic
 (home, irrigation, municipal, industrial)


- WELL COMPLETION DATA:
- (1) diameter (inches) 4
 - (2) total depth (feet) 124
 - (3) static water level (feet) 20 below above top of ground.
 - (4) casing plastic 116
(material) (depth)
4 if telescope see back.
(size)
 - (5) screen 3 116
(length) (depth to top)
4 (size) plastic (material)
 - (6) pump 1/2 10
(HP) (yield gpm)
Elco (type power)
 - (7) electric log no
(yes or/no)
(organization running log)
 - (8) how well bottom plugged completely

CODED

DRILLERS REMARKS: OCT 28 1971
 MISS. BD. OF
 WATER COMM.

If well telescopes please sketch and show depths.

GROUND LEVEL

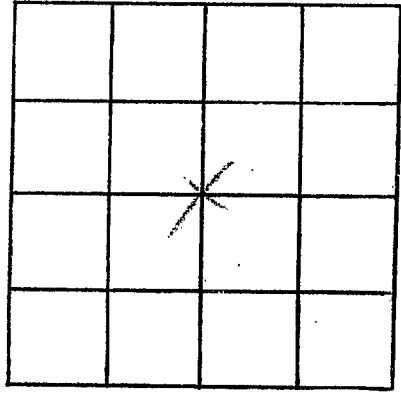

SECTION 29

Please indicate well location X.

ADDITIONAL INFORMATION

Lined area for additional information.

If more than one screen, show locations of each on sketch.