

LINCOLN
P28
9-27-71

MISSISSIPPI
BOARD OF WATER COMMISSIONERS
416 North State Street
Jackson, Mississippi 39201

WATER WELL DRILLERS LOG

CODED

27 Sept 1971
date well completed

S. F. Waterwell
firm name

Lincoln
county well located

LANDOWNER:

Douglas Nettles
Rogel Chitts
(mailing address)

description of formations encountered

from

to

clay	0	70
chert	70	40
red	40	60
sandstone	60	70

WELL LOCATION:

sec. 11 T 5 N R 7 E
2 miles S of P.O.
(distance) (direction) (nearest town)

WELL PURPOSE:

(home, irrigation, municipal, industrial)

WELL COMPLETION DATA:

- (1) diameter (inches) 4
- (2) total depth (feet) 70
- (3) static water level (feet) 50 below above top of ground.
- (4) casing PL 64 (material) (depth) (size) if telescope see back.
- (5) screen 6 64 (length) (depth to top) (size) (material)
- (6) pump 1/2 8 (HP) (yield gpm) (type power) electric
- (7) electric log (yes or no)

CODED

(organization running log)

(8) how well bottom plugged wood


NOV 10 1971

DRILLERS REMARKS:

MISS. BD. OF
WATER COMM.

If well telescopes please sketch and show depths.

GROUND LEVEL

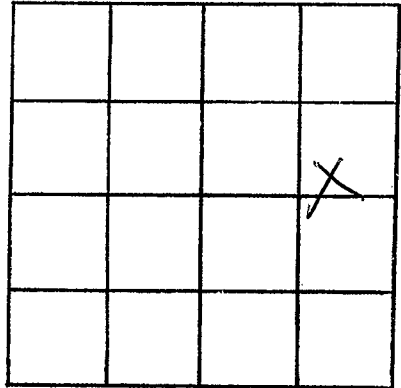

SECTION 11

Please indicate well location X.

ADDITIONAL INFORMATION

Lined area for additional information.

If more than one screen, show locations of each on sketch.