

LINCOLN

MISSISSIPPI
 BOARD OF WATER COMMISSIONERS
 416 North State Street
 Jackson, Mississippi 39201

CODED

WATER WELL DRILLERS LOG

LINCOLN

~~PKA~~
P29
 9-15-71

15 Sept 1971
 date well completed

SAF Waterwell
 firm name

county well located

LANDOWNER:
 James Dickson
 Johnston Station
 (mailing address)

description of formations encountered	from	to
Clay	0	15
Chalk	15	30
Sandstone	30	60
Chalk	60	75
Sand	75	115

WELL LOCATION:
 sec. 36 T 5 N R 1 E
 1 miles N of Johnston Sta
 (distance) (direction) (nearest town)

WELL PURPOSE:
 (home, irrigation, municipal, industrial)

- WELL COMPLETION DATA:**
- diameter (inches) 4
 - total depth (feet) 115
 - static water level (feet) 45 below above top of ground.
 - casing 41 99
 (material) (depth)
 (size) if telescope see back.
 - screen 6 99
 (length) (depth to top)
4 41
 (size) (material)
 - pump 1/2 8
 (HP) (yield gpm)
slat
 (type power)
 - electric log (yes or no) _____
 (organization running log) _____
 - how well bottom plugged wood

CODED


NOV 10 1971

DRILLERS REMARKS:

MISS. BD. OF
 WATER COM.

If well telescopes please sketch and show depths.

GROUND LEVEL

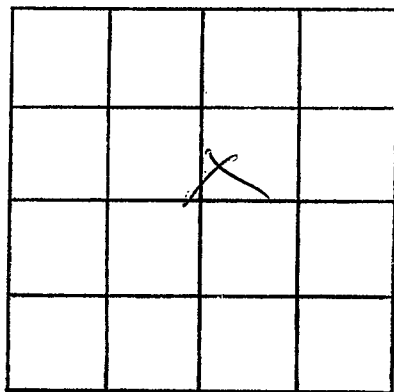

SECTION 36

Please indicate well location X.

ADDITIONAL INFORMATION

If more than one screen,
show locations of each on sketch.