

MISSISSIPPI  
BOARD OF WATER COMMISSIONERS  
416 North State Street  
Jackson, Mississippi 39201

**CODED**

WATER WELL DRILLERS LOG

**LINCOLN**  
**P 30**  
**10-25-71**

date well completed 10-25-71 firm name Chester Keener Lincoln county well located Lincoln

LANDOWNER: Thomas J. -  
H. D. Summit -  
(mailing address)  
WELL LOCATION:  
sec. 32 T. 4 N. R. 7 E  
5 miles NW Summit  
(distance) (direction) (nearest town)

description of formations encountered	from	to
Red clay	0	27
Red sand	27	72
Gravel & sand	72	98

WELL PURPOSE: Farm  
(home, irrigation, municipal, industrial)


WELL COMPLETION DATA:  
(1) diameter (inches) 4"  
(2) total depth (feet) 98  
(3) static water level (feet) 54 below top of ground;  
(4) casing (material) plastic (depth) bottom  
(size) if telescope see back.  
(5) screen (length) 6' (depth to top) 92'  
(size) (material) 4" plastic  
(6) pump (HP) 1/2 (yield gpm) 12  
(type power) electric  
(7) electric log no  
(yes or no)

**CODED**

(organization running log)  
(8) how well bottom plugged  
washed plug  
DRILLERS REMARKS:  
New house.

If well telescopes please sketch and show depths.

GROUND LEVEL

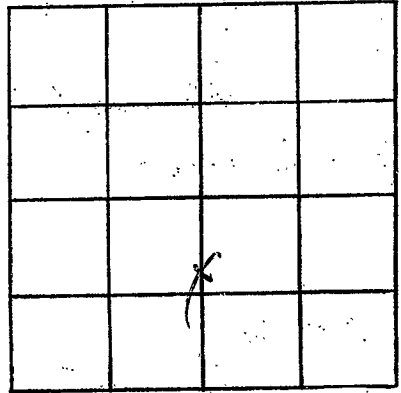

SECTION 92

Please indicate well location X.

ADDITIONAL INFORMATION

If more than one screen, show locations of each on sketch.