

LINCOLN
P32
2-25-72

MISSISSIPPI
 BOARD OF WATER COMMISSIONERS
 416 North State Street
 Jackson, Mississippi 39201

CODED

MAR 21 1972

WATER WELL DRILLERS LOG

Feb 25
 date well completed

1972


Fitzgerald Well Service
 firm name

Lincoln
 county well located

LANDOWNER:	description of formations encountered	from	to
<u>J.W. Holmes -</u> <u>R.R. Summit Miss.</u> (mailing address)	<u>red clay</u> <u>red sand</u> <u>red sand</u> <u>Common fault gravel</u>	<u>0</u> <u>10</u> <u>30</u> <u>90</u>	<u>20</u> <u>30</u> <u>90</u> <u>126</u>
WELL LOCATION: sec <u>34</u> T <u>5</u> N R <u>7</u> E <u>5</u> miles <u>N</u> of <u>Summit</u> (distance) (direction) (nearest town)			
WELL PURPOSE: <u>Home</u> (home, irrigation, municipal, industrial)			
WELL COMPLETION DATA: (1) diameter (inches) <u>4</u> (2) total depth (feet) <u>106</u> (3) static water level (feet) <u>40</u> below top of ground. (4) casing <u>plastic</u> <u>100</u> (material) (depth) <u>4</u> if telescope see back. (size) (5) screen <u>6</u> <u>100</u> (length) (depth to top) <u>4</u> <u>plastic</u> (size) (material) (6) pump <u>1/2</u> <u>22</u> (HP) (yield gpm) <u>alt</u> (type power) (7) electric log <u>ny</u> (yes or no) (organization running log) (8) how well bottom plugged <u>water plug</u>	<p style="text-align: center; font-size: 2em; font-weight: bold;">CODED</p>		
DRILLERS REMARKS:			

If well telescopes please sketch and show depths.

GROUND LEVEL

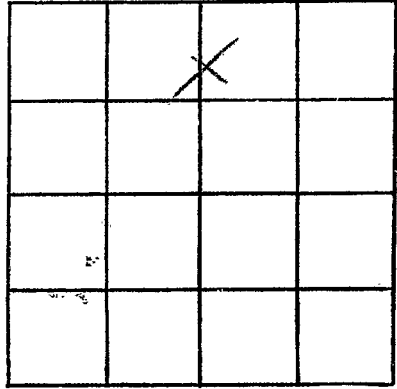

SECTION 34

Please indicate well location X.

ADDITIONAL INFORMATION

If more than one screen, show locations of each on sketch.