

LINCOLN
P 33
3-16-72

MISSISSIPPI
 BOARD OF WATER COMMISSIONERS
 416 North State Street
 Jackson, Mississippi 39201

CODED

WATER WELL DRILLERS LOG

March 16 1972 Gretn Water Well Cont. Lincoln
 date well completed firm name county well located

LANDOWNER:	description of fomations encountered	from	to
Assembly of God Church			
Bogue Chitto, Miss. (mailing address)			
WELL LOCATION:			
sec. 3 T 5 N R 7 E S W			
10 miles S of Brookhaven (distance) (direction) (nearest town)			
WELL PURPOSE: (home, irrigation, municipal, industrial)			
Church			
WELL COMPLETION DATA:			
(1) diameter (inches) 6			
(2) total depth (feet) 80			
(3) static water level (feet) 41 below above top of ground.			
(4) casing PVC 70 (material) (depth) 4" if telescope see back. (size)			
(5) screen 6' 70 (length) (depth to top) .010 PVC (size) (material)			
(6) pump 1/3 sub. 7 (HP) (yield gpm) electric (type power)			
(7) electric log no (yes or no) (organization running log)			
(8) how well bottom plugged wood			
DRILLERS REMARKS:			

CODED


APR 25 1972

MISS. Bd OF
 WATER COMM.

8

If well telescopes please sketch and show depths.

GROUND LEVEL

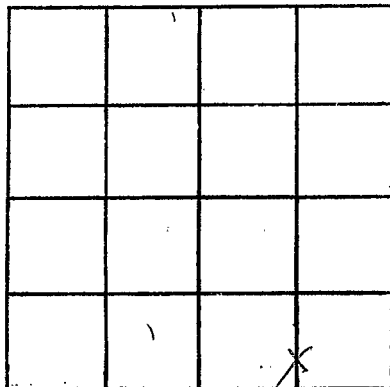

SECTION 3

Please indicate well location X.

ADDITIONAL INFORMATION

If more than one screen, show locations of each on sketch.