

**LINCOLN**  
**P34**  
**2-11-72**

MISSISSIPPI  
 BOARD OF WATER COMMISSIONERS  
 416 North State Street  
 Jackson, Mississippi 39201  
**WATER WELL DRILLERS LOG**

**CODED**

February 11 1972 Grenn Water Well Contractor Lincoln  
 date well completed firm name county well located

| LANDOWNER:  | description of formations encountered. | from | to  |
|---|--|------|-----|
| Fred Sasser   | Sand                                   | 0    | 98  |
| Route 4, Box 204                                      | Clay                                   | 98   | 110 |
| Bogue Chitto, Missl                                   |  |      |     |
| (mailing address)                                     |  |      |     |
| <b>WELL LOCATION:</b>                                 |  |      |     |
| sec. 23 T 5 N R 7 E                                   |  |      |     |
| 14 miles S of Brookhaven                              |  |      |     |
| (distance) (direction) (nearest town)                 |  |      |     |
| <b>WELL PURPOSE:</b> home                             |  |      |     |
| (home, irrigation, municipal, industrial)             |  |      |     |
| <b>WELL COMPLETION DATA:</b>                          |  |      |     |
| (1) diameter (inches) 6                               |  |      |     |
| (2) total depth (feet) 110                            |  |      |     |
| (3) static water level (feet) 45 below top of ground. |  |      |     |
| (4) casing PVC 90 (material), (depth)                 |  |      |     |
| 4" (size) if telescope see back.                      |  |      |     |
| (5) screen 6" 90 (length), (depth to top)             |  |      |     |
| .010 PVC (size), (material)                           |  |      |     |
| (6) pump 1/2 Sub 7 (HP), (yield gpm)                  |  |      |     |
| electric (type power)                                 |  |      |     |
| (7) electric log no (yes or no)                       |  |      |     |
| (organization running log)                            |  |      |     |
| (8) how well bottom plugged wood                      |  |      |     |
| <b>DRILLERS REMARKS:</b>                              |  |      |     |


**CODED**

REC'D FEB 25 1972

MISS. BD. WATER COM.

If well telescopes please sketch and show depths.

GROUND LEVEL

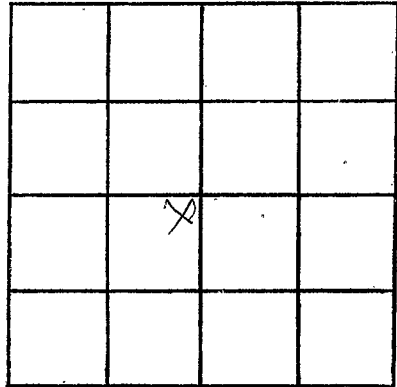

SECTION 23

Please indicate well location X.

ADDITIONAL INFORMATION

If more than one screen,  
show locations of each on sketch.